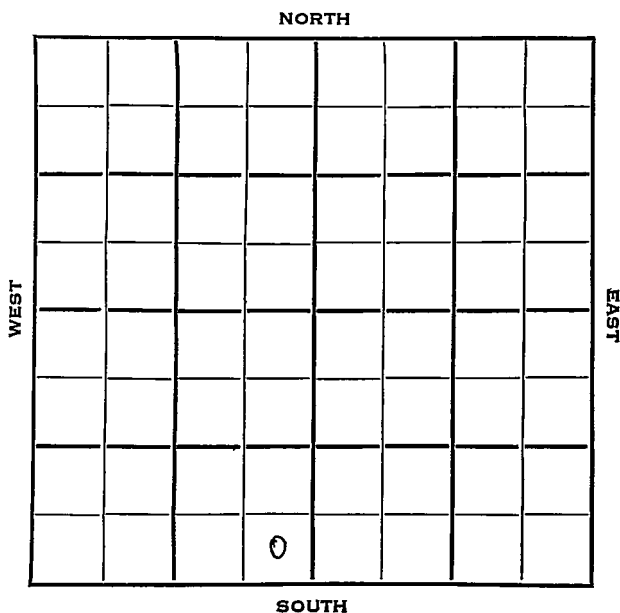


Section 11 Township 33 Range 42 WWell No. # 2 Greenwood "B"Company Cities Service

Morton KANSAS

SEC.	TWP.	R.
11	33	42W ✓

WELL NO.

2 Greenwood "B"

FARM

COMPANY

Cities Service

CONTRACTOR

Holm Drlg.

Greenwood Pool

Ft. from N. Line


330

Ft. from S. Line

330

Ft. from E. Line

Ft. from W. Line

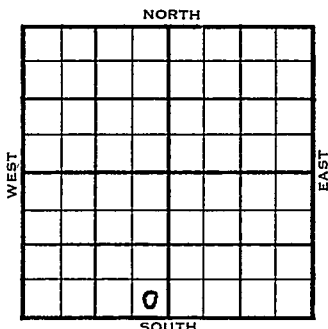

SE SE SW

	ELEVATION	REPORT
1953	3479'	
12/2	Spud 11-30-53	
	8" @ 600', WOC	
12/9	TD 3320'	
1954		
1/20	Spud 11-30-53	
	Gas Well	
	TD 3320'	
	8" @ 600'	
	Top 2938', Lens 3194'	
	TD 3320'	
	5" @ 3314'	
	CO to 3260	
	102/3218-42, 70/3198-3212, 5000A	
	PB 3120, 50/3088-98, 30/3076-82,	
	5000A	
	CO to 3320,	
	PB 3050	
	50/2998-3008, 30/2980-86, 20/2966-70,	
	80/2940-56, SSG, 3000A	
	4,380,000 gas, 2000A, CO to 3320	
	15,800,000 gas,	
	Comp. 20,400,000 gas 431#	

COMPLETED

J. G. McGEHEE

J. G. McGEHEE