


Section 11 Township 33 Range 43W

Well No. 1 Smith "p"

Company Cities Service

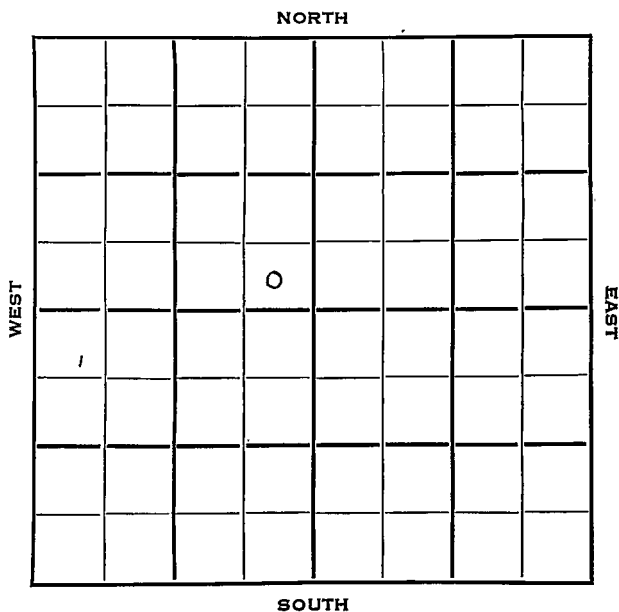

Morton

KANSAS ✓

Sec. 11 Twp. 33 R. 43W

Well No. #1 Smith "P" Farm

Cities Service Company


Holme Drlg. Contractor

_____ Ft. from N. Line

330 Ft. from S. Line

330 Ft. from E. Line

_____ Ft. from W. Line

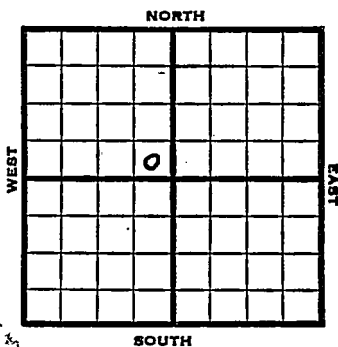

SE SE NW

1953

Elev. 3573'

REPORT

4/8 Location

4/16 8" @ 600'
Drlg 2705'

4/23 RTD 3240
5" @ 3239'

4/30 N.R.

5/7 Testing

5/21 "

5/28 "

6/3 "

6/10 "

6/24 Spud 4-8-53

Gas Well

TD 3240

8" @ 600

TD 3240

5" @ 3239

Top 2846, Lans 3100

CO to 3197, 20/3180-84, 20/3172-76,

30/3156-62, 80/3132-48, 784,000 gas

90/3102-20, 5000A 14 mdfg

PB 3080 25/3052-57, 20/3001-05,

60/2984-96, 3,360,000 gas

Perf/2976-81, 3000A

Handwritten calculation:

$$\begin{array}{r} 3573 \\ 2846 \\ \hline 727 \\ + 473 \\ \hline 3100 \end{array}$$

OVER

#1 Smith "P"
(Information Brought Forward)

1953

6/24

23 2/3 mcg 6000A
CO to 3197 26 $\frac{1}{4}$ mcfg
PB 2957 20/2935-39, 25/2922-27,
40/2910-18, 50/2894-2904, 25/2880-85,
70/2850-64, 5000A
4,950,000 gas, 6000A
CO to 3197, 20 mcfg 6000A
Comp. 30 mcfgpd 434#

COMPLETED

