

Form 51—3M—1-35—33340

Map No. KANSAS Sec. 11 Twp. 33 R. 39

Well No. 1-10 Christopher Farm

Argus Gas Company

NORTH

WEST

EAST

SOUTH

Location _____
Drilling Remarks _____

Rig Up _____
Drilling Remarks

RECORD

Cased _____ in. _____ ft.

Sand _____

Gas _____


Oil _____

Total Depth _____

PRODUCTION
 1st 24 hrs. Nat.-----
 1st 24 hrs. after shot-----
 Gas-----cu. ft.-----
 Dry Hole-----
 Abandoned-----

Map No. KANSAS Sec. 11 Twp. 33 R. 39^u
 Well No. 1-Christopher Farm
Argus Gas Company

NORTH

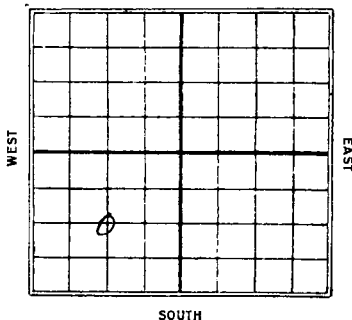

_____ Ft. from N. Line

1320 Ft. from S. Line

_____ Ft. from E. Line

1320 Ft. from W. Line

1930

Date	REPORT
3/26	Run up.
4/2	Hold 400'
4/9	" 1012'
4/16	" 2346'
4/23	Run 8" 2456'
4/30	Top sand 2460'
	Big gas 2485'
	Hold 2496' 6 1/2" gas
5/7	No report
5/14	Land 2460-2990
	TD 2990
	@ 12 1/2 ft gas
	Comp.


Map No. KANSAS Sec. 11 Twp. 33 R. 29 W

Well No. 1 Christopher

Argus Gas Company

Contractor

SECTION PLAT

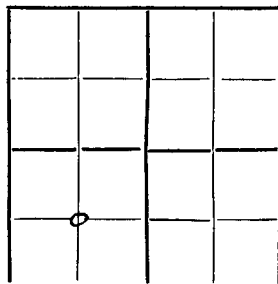

.....Ft. from N. Line

1320 Ft. from S. Line

.....Ft. from E. Line

1320 Ft. from W. Line

FIRST SECTION

Location.....

Rig up.....

Drilling and Remarks:

Rigging up

RECORD

Cased.....in.,ft.

Sand.....

Gas.....

Oil.....

Total Depth.....

PRODUCTION

1st 24 hrs. Nat.....

1st 24 hrs. after shot.....

Gas.....Cu. Ft.

Dry Hole.....

Abandoned.....

Date

1930

S. J. LEWIS

.....192.....

Scout



SECTION PLAT

..... Ft. from N. Line

1320 Ft. from S. Line

..... Ft. from E. Line

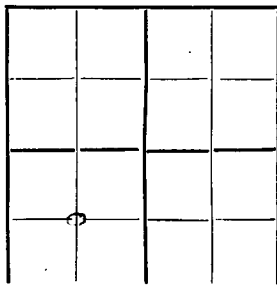1320 Ft. from W. Line

COMPLETED

Location.....

Rig up.....

Drilling and Remarks:

12' 2 1/2 Gas.

RECORD

Cased..... in., ft.

Sand 2460 - 2990

Gas.....

Oil.....

Total Depth 2990

PRODUCTION

1st 24 hrs. Nat.....

1st 24 hrs. after shot.....

Gas..... Cu. Ft.

Dry Hole.....

Abandoned.....

Date

MAY 14 1930 Scout