


DX 78-1 Morton

KANSAS

Section ~~31~~ // Township 33 Range 41W

Well No. #1-Barker

Company Panhandle Eastern

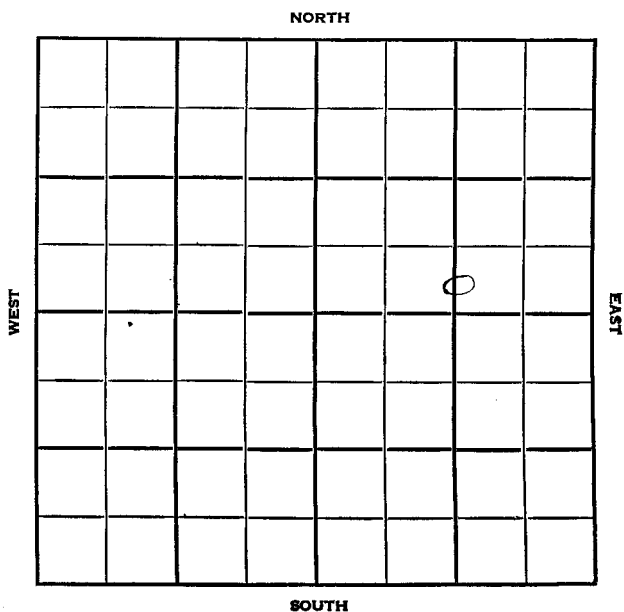

Morton

KANSAS

SEC.

TWP.

R.

11

33

41W

WELL NO.

#1-11
#1 Barker

FAR

COMPANY

Panhandle Eastern

CONTRACTOR

Michaelis

Hugoton

2540

FT. FROM N. LINE

FT. FROM S. LINE


1320

FT. FROM E. LINE

FT. FROM W. LINE

C S $\frac{1}{2}$ S $\frac{1}{2}$ NE

NORTH

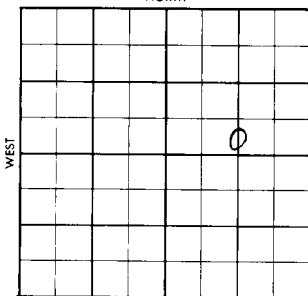

SOUTH

1956

ELEVATION

REPORT

6-6

Comm. 5-30-56
7" @ 426 w/125
Drlg. 2290

FIRST REPORT
JUN 6 1966

Date Comm. 5-30-56
7th @ 126/185 @ 1st. 2290

3429

County Morton Elev. 3426
 Sec. 11 Twp. 33 Rge. 11W (3429)
 Company Parhandle Eastern
 Farm Name Barker No. 1-11

TOPS	DEPTH	LOG	DATUM	Loc. in Sec.
Anh.				
Tp. <u>KRI</u>		<u>2210</u>		<u>C S¹ S¹ NE</u>
H. <u>WFD</u>		<u>2223</u>		<u>2510' NL</u>
Tr.				<u>1320' E L</u>
Dg.				
Bl.				
L.				
K.C.				Geol. _____
B.K.				Centre _____
Ce.				<u>Michaelis</u>
C.				
M.				Pool _____
M.				<u>Hugoton</u>
K.				
Ma.				
Me.				
V.				
S.				
S.				
A.				
R.				
PE.				
G.				
XD.		<u>2371</u>		

SEP 12 '56
 COMPLETE

Date Comm. 5-30-56
7" @ 126/125 drl. 2290 JUN 13 '56
to 3371 2371 4 1/2 2348/200
CO JUN 20 '56 12/ 2275-77 42/
2280-87 18/ 2291-94 11 9a
4600 MCF /3/ No test PB 2265
24/ 2254-58 36/ 2242-48 24/
2228-32 60/ 2213-23 11 9a
374 MCF 20 To Bot. /14 No 9a
Ran Th 91 511 JUN 27 '56 JUL 3 '56 JUL 11 '56

JUL 18 '56

JUL 25 '56

AUG 1 '56

AUG 8 '56

AUG 15 '56

AUG 22 '56

AUG 29 '56

SEP 5 '56

SEP 12 '56

DELIV. TST

1.739 MCF

SIX 402#