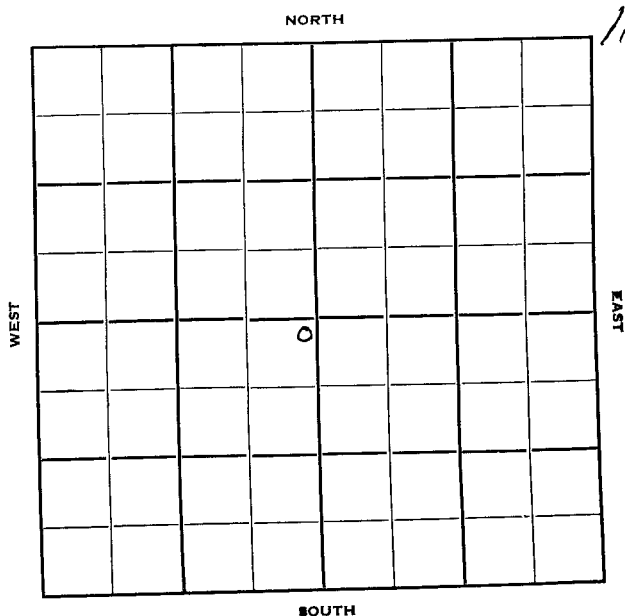


Section 11 Township 33 Range 35-WWell No. #1 AldermanCompany Northern Natural

Stevens

KANSAS

Sec. 11 Twp. 33 R. 35W ✓

Well No. #1 Alderman Farm

Northern Natural Company

Moran Contractor

200' Hugoton Pool

Ft. from N. Line


Ft. from S. Line

100'

Ft. from E. Line

Ft. from W. Line

NE SW

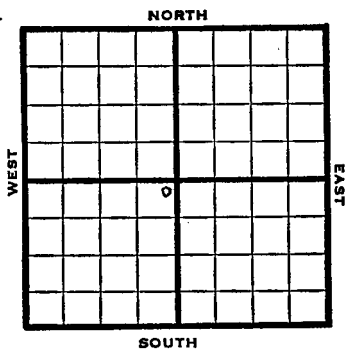

1950

Elev 2944

# REPORT

6/21 Location

8/9 10" @ 613

7" @ 2610

TD 2771

Hol 2565

Her 2610

Krider 2685

in 2734

15000 total acid

Comp 13,632,000 open flow

408#

Completed

**COMPLETED**

Kansas

Hugoton Pool

Map No. \_\_\_\_\_ Sec. 11 Twp. 33 R. 35W

Well No. 1 Alderman

Northern Natural Company

Moran Contractor

NE SW

## SECTION PLAT



200 Ft. from N. Line

Ft. from S. Line

100 Ft. from E. Line

Ft. from W. Line

Stevens County

Location X

Rig up

Drilling and Remarks:

## RECORD

Cased \_\_\_\_\_ in., \_\_\_\_\_ ft.

Sand \_\_\_\_\_

Gas \_\_\_\_\_

Oil \_\_\_\_\_

Total Depth \_\_\_\_\_

## PRODUCTION

1st 24 hrs. Nat. \_\_\_\_\_

1st 24 hrs. after shot \_\_\_\_\_

Gas \_\_\_\_\_ Cu. Ft.

Dry Hole \_\_\_\_\_

Abandoned \_\_\_\_\_

Date

JUN 21 1950 19

J. E. TYRA

Scout


County Stevens State Kansas

Sec. 11 (Blk. Twp.) 33 (Sur. Rge.) 35W Map No.

Operator Northern Natural

Well No. 1 Farm Alderman

Elev. 2944 Location NE SW

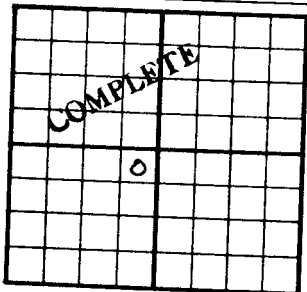

200 Ft. From N Line SW

100 Ft. From E Line Quarter

1st. Report

Completion AUG 9 1950

Remarks

Spudding Date

Drlg. Data

10" @ 613 7" @ 2610 TD 2771

Hol. 2565 Her. 2610 Krider 2685

Win. 2734 15000 total acid

Comp. 13,632,000 open flow 408#

J. E. TYRA