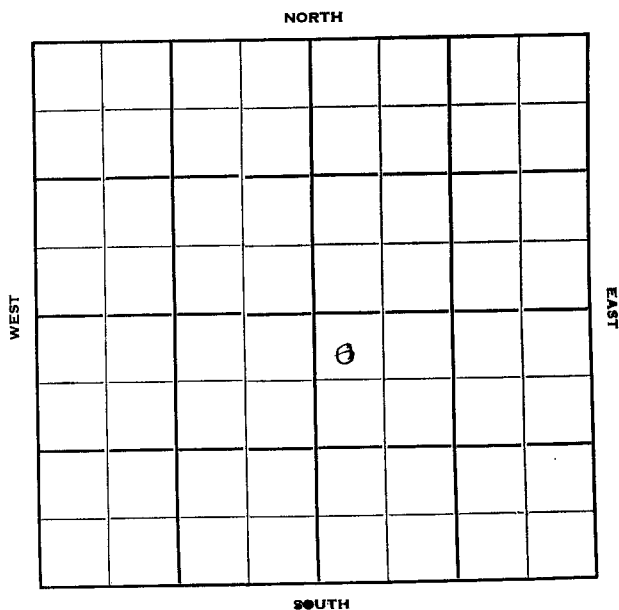


Section 11 Township 33 Range 34WWell No. #1 H.A. McGeeCompany Cabot Carbon

Seward

KANSAS

Sec. 11 Twp. 33 R. 34W ✓

Well No. #1 H. A. McGee Farm

Cabot Carbon Company

Contractor

Hugoton Pool


330' Ft. from N. Line

Ft. from S. Line

Ft. from E. Line

330' Ft. from W. Line

NW NW SE

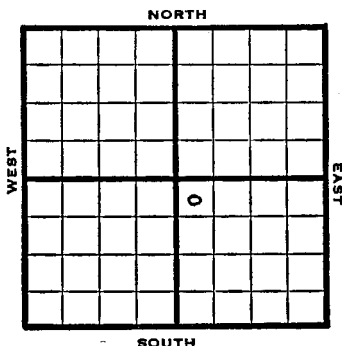

1950

Elev. 2869'

REPORT

11/29

Spud 11-21-50
Drlg. 550'

1951

3/14

Spud 11-21-50

Gas well


TD 2672'

10" @ 539, 7" @ 2575, TD 2672'

Her. 2575, Krider 2602, Win. 2668,
19,000 A

Comp. 15,300,000 gas 406#

COMPLETED

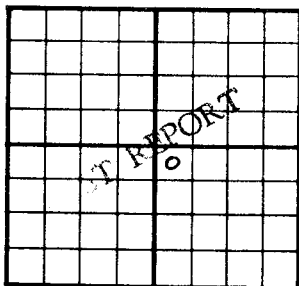County **Seward** State **Kansas**Sec. **11** (Blk. Twp.) **33** (Sur. Rge.) **34W** Map No.Operator **Cabot Carbon**Well No. **1** Farm **H. A. McGee**Elev. Location **NW NW SE****330** Ft. From **N** Line **SE****330** Ft. From **W** Line Quarter


1st. Report NOV 29 1950

Completion

Remarks

Spudding Date **11-21-60**Drlg. Data **Hugoton Pool****drlg. 550**

J. E. TYRA

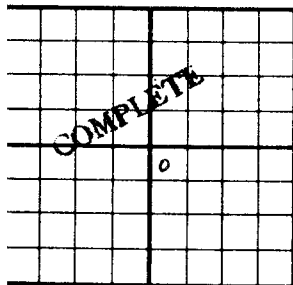County Seward State KansasSec. 11 (Bk.
Twp.) 33 (Sur.
Rge) 34W Map No.Operator Cabot CarbonWell No. 1 Farm H. A. McGeeElev. 2869 Location NW NW SE330 Ft. From N Line SE330 Ft. From W Line QuarterIst. ReportCompletion MAR 14 1951Remarks Hugoton PoolSpudding Date 11-21-50Orig. Data Gas well TD 267210" @ 539 7" @ 2575 TD 2672Her. 2575 Krider 2602 Win. 266819000 A Comp. 15,300,000 gas 406 $\frac{1}{2}$ "

J. E. TYRA