


Section 24 Township ~~32~~ 33 Range 12W

Well No. #1 Long

Company Bachus Oil

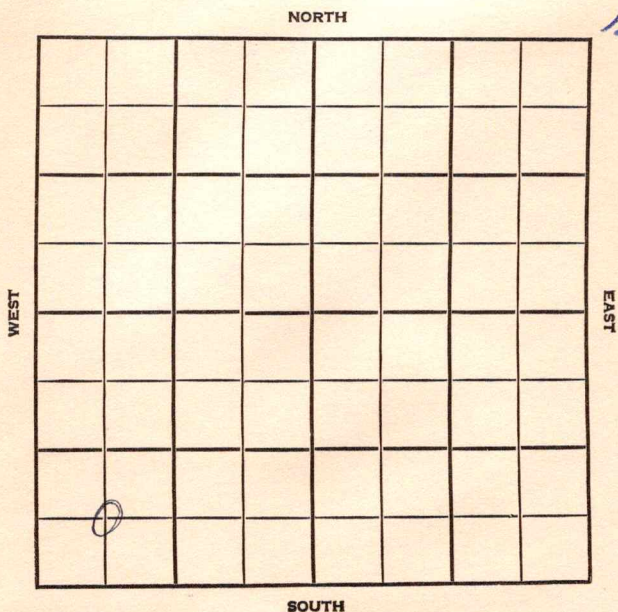

CORRECTION

County Barber Elev. 1445
 Sec. 24 Twp. 33-32 Rgs. 12W
 Company Bachus Oil
 Farm Name Long No. 1

TOPS	DEPTH	LOG	DATUM	Loc. in Sec.
Anb.				C SW SW
Tp.				
H.	3641			
Tr.				
Dg.				
Bl.				
L.	3821			Geol.
K.C.				Contr. <u>Prime</u>
B.K.C.	4325			
Ce.				
C.				
M.	4510			<u>Nippewilla</u>
M.				<u>Pool</u>
K.				
Mz.				
Me.				
V.				
S.				
S.				
A.				
R.				
PE.				
G.				
TD.	4630			

COMPLETE
 MAR 6 1957

Date Comm. Mag F.O.
 Location NOV 7 '56 11-1-56 8578
355/215 ID 2420 NOV 13 '56 ID 4195
NOV 21 '56 DST 4513-30 1hr G/23"
stabil @ 155 MCF /30" rec 110' GCM
FP 50-85 BHP 1665/30" DST
4530-60 90" G/5" ga 362 MCF
110" rec 75' V50 & GCM + 60' V50
& GCMW + 120' MW FP 140-250
BHP 1665/30" DST 4562-4630

1hr 25' Md BHP 80 5 1/2

@ 4628/150 WOCT NOV 28 '56 MID

DEC 9 '56 165~~2~~ / 4514-47 Frac 10 X 10Flwd 6 ^{608d} 30pk n/w + 6 Mill

CFGPD DEC 12 '56 DEC 19 '56 ✓ DEC 26 '56 JAN 2 '57

JAN 9 '57

JAN 16 '57

JAN 23 '57

JAN 30 '57

FEB 6 '57

FEB 13 '57

FEB 20 '57

Deliv. + st.

2 Mill CFGPD FEB 27 '57 MAR 6 '57

Deliv. + st 2 Mill. CFGPD

SICP 1331# FCP 1039#

County Barber Elev. _____
 Sec. 24 Twp. 32 Rge. 12W
 Company Bachus Oil
 Farm Name Long No. 1

TOPS	DEPTH	LOG	DATUM
Anh.			
TP.			
H.			
Tr.			
Dg.			
BL.			
L.			
K.C.			
B.K.C.			
Ce.			
C.			
M.			
M.			
K.			
Mz.			
Me.			
V.			
S.			
S.			
A.			
R.			
PE.			
G.			
T.D.			

Loc. in Sec. C SW SW
 Geol. _____
 Contr. _____
 Pool _____

FIRST REPORT
 OCT 31 '56
 0

Date Comm. _____
 Location _____

Co.
 Lse.
 No.
 Sec.
 T.
 R.

NOV 5 1956

R.G.