


Section 30 Township 33S Range 12W

Well No. #1 Page McCullough

Company Rupp-Ferguson

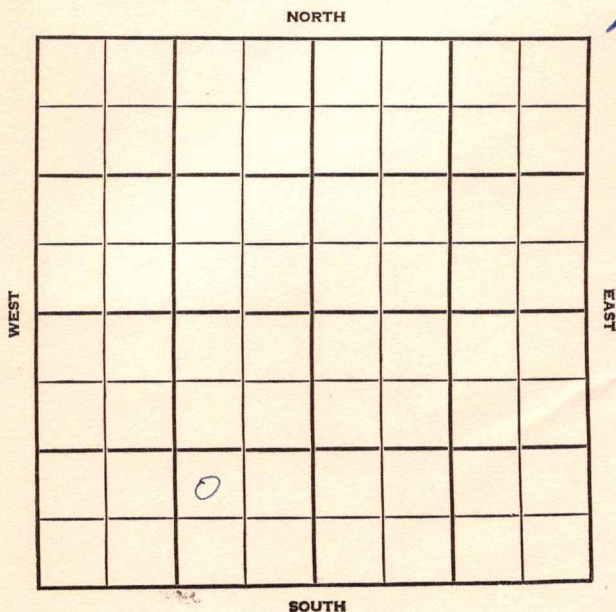

SEC.	TWP.	R.
30	33	12W

WELL NO.

#1 Page McCullough

FARM

COMPANY

Rupp-Ferguson

CONTRACTOR

Driftwood


____ FT. FROM N. LINE

____ FT. FROM S. LINE

____ FT. FROM E. LINE

____ FT. FROM W. LINE

NW SE SW

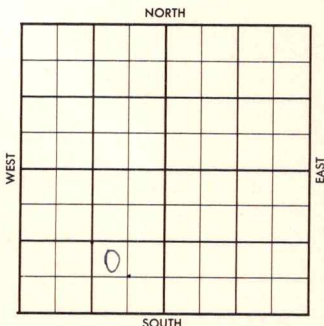

1956

ELEVATION

1499

REPORT

7-25

Comm. 7-18-56

13 3/8" @ 250 w/200

Drlg. 3355'

9-5

Comm 7-18-56

Tops:

Elg 3526, H 3717, Dg 3800, L 3887

M 4485, K 4698, Chat 4764,

V 4810 S 4911

TD 4920

13 3/8" @ 200

DST 4465-4504 40" g/2"

ga 1,250 MMF in 5" 1,710

MCF in 7" rec 120' GCM FP 430-400

1730/20"

DST 4908-20 1 hr 78' md + 126'

MW BHP 1880/20 5 1/2" @ 4617/150

CO 4580 40/4488-98 40/4506-16

ga 792 MCF nat frac frac tbg to

4469, flwd ld + 15 to 20 Mill CF

CSO gauge 5 mill CFG

CSO ga 5 mill CFGPD

COMPLETED

County Barber Elev. _____
Sec. 30 Twp. 33S Rge. 12W
Company Rupp-Ferguson
Farm Name Page McCullough No. 1

TOPS	DEPTH	LOG	DATUM	Loc. in Sec.
Anh.				NW SE SW
Tp.				
H.				
Tr.				
Dg.				
Bl.				
L.				Geol. _____
K.C.				Contr. _____
B.K.C.				
Ce.				
C.				
M.				
M.				Pool _____
K.				Driftwood
Mz.				
Me.				
V.				
S.				
S.				
A.				
R.				
Pe.				
G.				
T.D.				

Date Comm. 7/18/56
13°3/8 250 w/200 D 3355

[Red handwritten mark]

2201 I 20A

R.C.R.

County Barber Elev. 1477
 Sec. 30 Twp. 33S Rge. 12W
 Company Rupp-Ferguson
 Farm Name Page McCullough No. 1

TOPS	DEPTH	LOG	DATUM	Loc. in Sec.
Anh. <u>E19</u>	<u>3526</u>			NW SE SW
Tr.				
H.	<u>3717</u>			
Tr.				
Dg.	<u>3800</u>			
Bl.				
L.	<u>3887</u>			Geol.
K.C.				Contr.
B.K.C.				
Ce.				
C.				
M.	<u>4485</u>			Pool
M.				
K.	<u>4698</u>			Driftwood
Mr. <u>Chatan</u>	<u>4764</u>			
Mo.				
V.	<u>4810</u>			
S.	<u>4911</u>			
S.				
A.				
R.				
Pe.				
G.				
T.D.	<u>4920</u>			

COMPLETE

SEP 5 '56

Date Comm. 7/18/5613" 3/8 250 w/200 D 3355 AUG 1 '56DST 4465-4504 40" 9/2"9a 1.250 MCF in 5" 1.710MCF in 7" net 120' GCMFP 430-400 1730 120" D4550 AUG 8 '56 DST 4908-201 hr78' Md + 126' MW BHP 1880/205 1/2 @ 4617/150 AUG 15 '56 CO 458040/4488-98 40/4506-16 SEP 5 '56

9a 792 MCF nat. Frac

~~1/4~~ Frac T69 to 4469

Plwd Ld +15 To 20 Mill CF

AUG 22 '56

AUG 29 '56

CSO 9209e

5 Mill CFG 5.1 SEP 5 '56

CSO 9a. 5 Mill CFG-pd.