


Barber

KANSAS

SECTION 31 TOWNSHIP 33 RANGE 12 W

WELL NO. #1 Hall "G"

COMPANY Petroleum Inc.

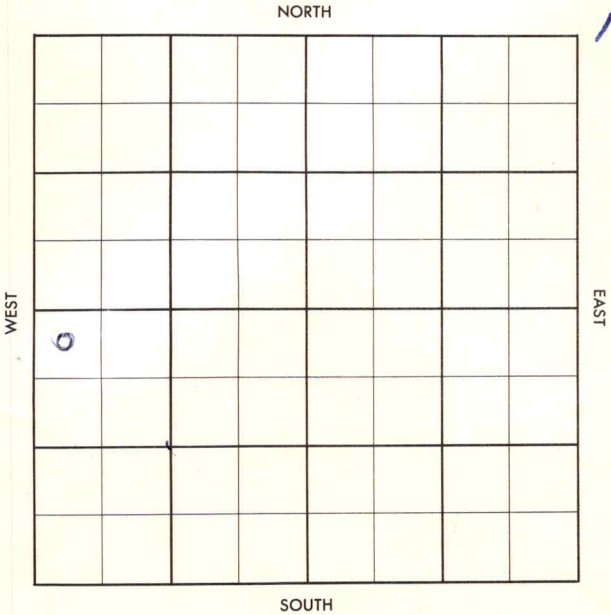

Barber

KANSAS

SEC. 31	TWP. 33	R. 12W
------------	------------	-----------

WELL NO.

#1 Hall "G"

FARM

COMPANY

Petroleum Inc.

CONTRACTOR

Co. Tools


_____ Ft. from N. Line

_____ Ft. from S. Line

_____ Ft. from E. Line

_____ Ft. from W. Line

NW NW SW

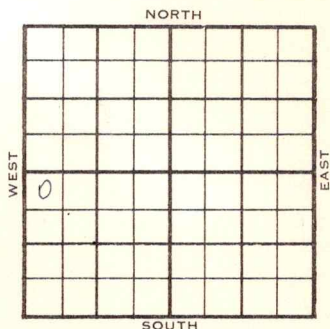

1956

ELEVATION

1499

REPORT

3-14

Comm. 3-9-56

8" @ 284

Drlg. 2510

4-11

DST 4526-60 op 15 min. gas in 2 min.
3500 mcfg, rec. 1800 gcm, 1730#4 $\frac{1}{2}$ " @ 4627

CO to 4593, 40/ 4574-82, 140/4536-64

40/ 4524-32, 3633 mcfg, 3267 mcfg,

3 hrs., 500 A, 4407 mcfg, frac,

5 mcfg, frac

Comp. open flow 33,330 mcfgpd

Elgin 3530

H. 3708

Dg. 3807

L. 3896

M. 4526

TD 4630

COMPLETED

County	Barber	Elev.	1644
Sec.	31	Twp.	33
		Rge.	12W
Company	Petroleum Inc.		
Farm Name	Hall "G"		No. 1

TOPS	DEPTH	LOG	DATUM	Loc. in Sec.
Anh.				NW NW SW
Tr.				
H.				
Tr.				
Dg.				
Bl.				
L.				Geol.
K.C.				
B.K.C.				Contr.
Ce.				Co. tools
C.				
M.				Pool
M.				
K.				
Mz.				
Mq.				
V.				
S.				
S.				
A				
R.				
Pe.				
G.				
T.D.				

Lse.

No.

Date Comm. 3-9-56
8" @ 284 drlg. 2510


County Barber Elev. 1499
 Sec. 31 Twp. 33 Rge. 12W
 Company Petroleum Inc.
 Farm Name Hall "G" No. 1

TOPS	DEPTH	LOG	DATUM	Loc. in Sec.
Anh.				
Tp. <u>E1917</u>	<u>3530</u>		<u>2031</u>	<u>NW NW SW</u>
H.	<u>3708</u>		<u>2209</u>	
Tr.				
Dg.	<u>3807</u>		<u>2308</u>	
BL.				
L.	<u>3896</u>		<u>2397</u>	Geol.
K.C.				Contr.
B.K.C.				Co. tools
Ce.				
C.				
M.	<u>4526</u>		<u>3027</u>	Pool
M.				
K.				
Mz.				
Mq.				
V.				
S.				
S.				
A.				
R.				
Pe.				
G.				
T.D.	<u>4630</u>			

COMPLETE

Date Comm. 3-9-56 APR 11 1956

8" @ 284 DST 4526-60 open 15 min.

gas in 2 min. 3,500 mcfg rec. 180! gcm

1730# 4 $\frac{1}{2}$ " @ 4627 CO to 4593

40/4574-82 140/1536-64 40/4524-32

3,633 mcfg 3,267 mcfg 3 hr.

500 A 4,407 mcfg frac 5 mcfg

frac Comp. open flow 33,330 mcfgpd