

DX 78-1

Section 24 Township 33 Range 12W
Well No. 1 J. W. Long
Company Ben F. Brack

NORTH

2

					0		

SOUTH

WEST

EAST

Barber

KANSAS

SEC.	24	TWP.	33	R.	12W ✓
------	----	------	----	----	-------

WELL NO.

1

J. W. Long

FARM

COMPANY

Ben F. Brack

CONTRACTOR

Brack

Nippawalla Gas Pool

330


Ft. from N. Line

Ft. from S. Line

Ft. from E. Line

990

Ft. from W. Line

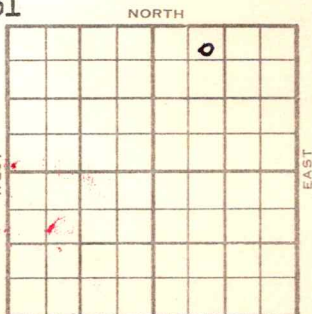

NE NW NE

Doug. sd. test
Magnolia FO

1954

ELEVATION

1428

REPORT

6/9

Spudding 6-5-54

8" @ 196

Drlg. 1655

6/23

Spudding 6-5-54

8" @ 196

Heeb 3584

TD 3750

D & A

ABANDONED

County Barber State KansasSec. 24 (Blk.) 33 (Sur.) 12W Map No.Operator Ben F. BrackWell No. 1 Farm J. W. LongElev. 1428 Location NE NW NE330 Ft. From N Line NE990 Ft. From W Line Quarter

1st. Report

Completion JUN 23 1954Remarks Nippawalla Gas Pool
Brack - Contr.Spudding Date 6-5-54

Drig. Data

8" @ 196 Heeb. 3584 TD 3750D & A

County **Barber** State **Kansas**Sec. **24** (Blk.) **33** (Sur.) **12W** Map No.Operator **Ben F. Brack**Well No. **1** Farm **J. W. Long**Elev. Location **NE NW NE**

FIRST REPORT

330 Ft. From **N** Line **NW****990** Ft. From **W** Line Quarter1st. Report **JUN 9 1954**

Completion

Remarks **Doug. sd. test**
Magnolia farmout**Brack - Contr.**Spudding Date **6-5-54**Drlg. Data **Nippawalla Gas Pool****8" @ 196 drlg. 1655****J. G. McGEHEE**