


Barber

KANSAS

SECTION 31 TOWNSHIP 33 RANGE 12 W

WELL NO. # 1 McCracken "A"

COMPANY Bachus Oil

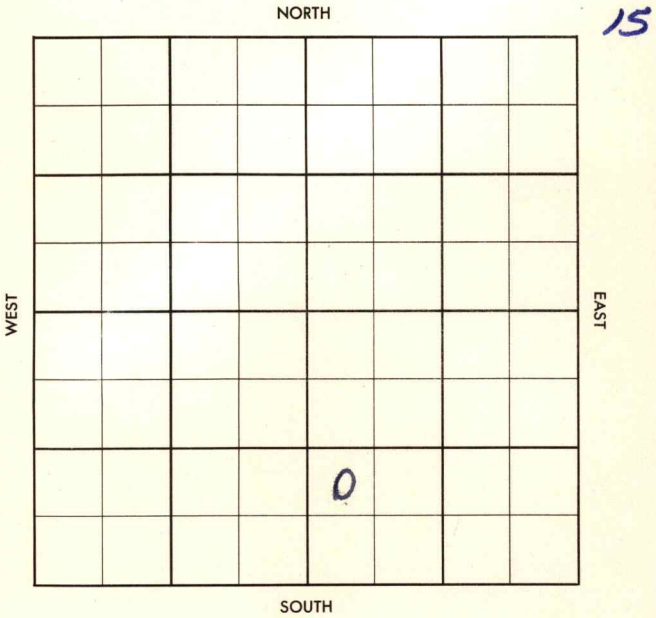


SEC. 31	TWP. 33	R. 12W
------------	------------	-----------

WELL NO. #1 McCracken "A" FARM

COMPANY Bachus Oil

CONTRACTOR Strata Driftwood

_____ Ft. from N. Line
 _____ Ft. from S. Line
 _____ Ft. from E. Line
 _____ Ft. from W. Line

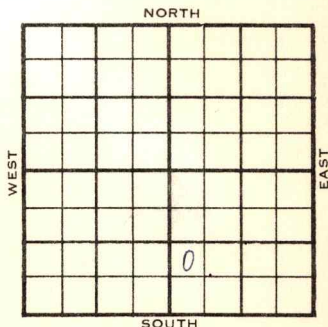

NW SW SE

1956	ELEVATION 1596'	REPORT
------	--------------------	--------


4-25 Comm. 4-18-56
 8" @ 298 w/200
 Drlg. 3280

5-29 DST 4623-47 op 45 min. gas in 2 min.
 ga. 2.600 MCF, rec 100' GCM, BHP 1630#
 DST 4647-4722 op 1 hr. rec. 60' mud,
 BHP 240/30"
 5 1/2" @ 4722
 CO 110/4625-47, 104/4652-78
 Est 15 mill. cfg
 Frac, ga 16 mill. cfg, ##
 ga. 17 million cfgpd
 H. 3800', L. 3978', M. 4622'.
LDg tops; H. 3802', Dg. 3880',
L. 3980', BKC 4420', ~~###~~ M.4624'
 TD 4722'

COMPLETED

County Barber Elev. 1576
 Sec. 31 Twp. 33 Rge. 12W
 Company Bachus Oil
 Farm Name McCracken "A" No. 1

TOPS	DEPTH	LOG	DATUM	Loc. in Sec.
Anh.				NW SW SE
TP.				
H.	3800	3802		
Tr.				
Dg.		3880		
Bl.				
L.	3978	3980	2909	Geol.
K.C.				
B.K.C.		4420	2844	Contr.
Ce.				Strata
C.				
M.	4622	4624	3048	Pool
M.				Driftwood
K.				
Mz.				
Me.				
V.				
S.				
S.				
A.				
R.				
PE.				
G.				
TD.	4722			

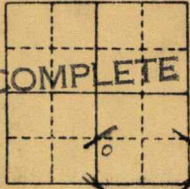

Date Comm. 4-18-56 MAY 29 1956
8" @ 298/200 drlg. 3280 MAY 2 '56

DST 4623-47 45" 9 in 2" ga
2,600 MCF rec 100' GCM BHP
1630/ DST MAY 9 '56 4647-4722
1hr rec 60' Md BHP 240/30" 5 1/2
@ 4722 co 110/4625-47
104/4652-78 est 15 Mill CFB
1/2 Frac MAY 16 '56 MAY 23 '56 ga 16
Mill. CFB. MAY 29 '56 ga 17 Million CFBPD

County Barber Elev. _____
 Sec. 31 Twp. 33 Rge. 12W
 Company Bachus Oil
 Farm Name McCracken "A" No. 1

TOPS	DEPTH	LOG	DATUM	Loc. in Sec.
Anh.				NW SW SE
Tr.				
H.				
Tr.				
Dg.				
Bl.				
L.				Geol. _____
K.C.				Contr. _____
B.K.C.				
Ce.				Strata
C.				
M.				
M.				Pool
K.				Driftwood
Mz.				
Me.				
V.				
S.				
S.				
A.				
R.				
Pe.				
G.				
T.D.				

APR 25 '56
 FIRST REPORT
 10

Date Comm. 4-18-56
8" @ 298/200 drlg. 3280

(Faint red stamp: MAY 5 1956)
(Large red handwritten mark: 216)
(Faint red stamp: R.G.)

Co.
Lse.
No.
Sec.
T.
R.