


DX 78-1 Barber

KANSAS

Section 32 Township 33 Range 12W

Well No. #1 Vala Smith

Company Skelly Oil Co

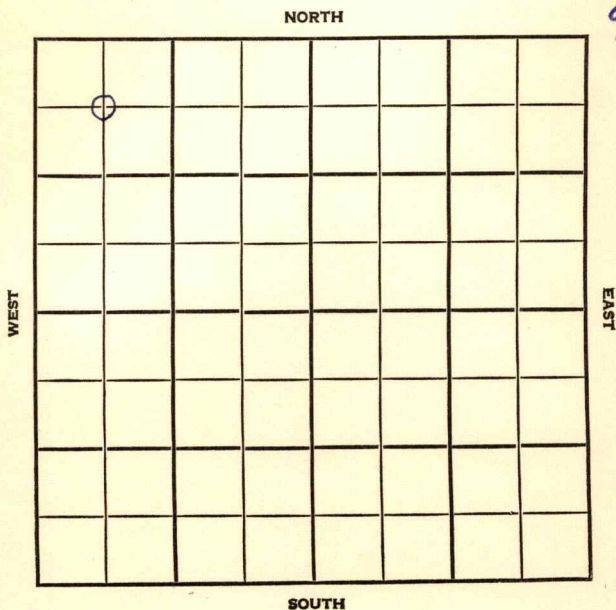

Barber

KANSAS

SEC.

32

TWP.

33

R.

12W

WELL NO.

#1 Vala Smith

FARM

COMPANY

Skelly Oil Co.

CONTRACTOR

Hulme Drlg.

Driftwood


_____ FT. FROM N. LINE

_____ FT. FROM S. LINE

_____ FT. FROM E. LINE

_____ FT. FROM W. LINE

C NW NW

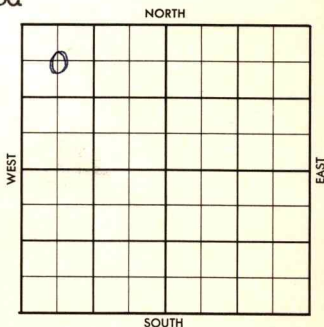

1956

ELEVATION

REPORT

8-29

MIRT

County Barber Elev. _____
 Sec. 32 Twp. 33 Rge. 12W
 Company Skelly Oil Co.
 FarmName Vala Smith No. 1

TOPS	DEPTH	LOG	DATUM
Anh.			
TP.			
H.			
Tr.			
Dg.			
BL.			
L.			
K.C.			
B.K.C.			
Ce.			
C.			
M.			
M.			
K.			
Mz.			
Mq.			
V.			
S.			
S.			
A.			
R.			
PE.			
G.			
ED.			

Loc. in Sec. _____

C NW NW


Geol. _____

Contr. _____

Hulme Drlg

Pool _____

Driftwood

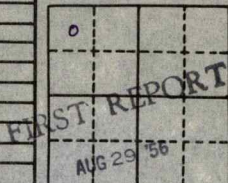

Date Comm. _____

MIRT

2381 2 132

D. J.

County Barber Elev. 1469
 Sec. 32 Twp. 33 Rge. 12W
 Company Skelly Oil Co.
 Farm Name Vol. Smith No. 1

TOPS	DEPTH	LOG	DATUM	Loc. in Sec. _____
Anh.				C NW NW
TP.				
H.		3680		
Tr.				
Dg.		3768		Geol. _____
BL.		3853		
L.		3858		
K.C.				
B.K.C.		4349		Contr _____
Ce.				
C. <i>Marm</i>		4399		
M.		4496		
M.				Pool _____
K.		4670		
Mz.				
Me.				
V.				0 SEP 19 '56 ABANDONED
S.				
S.				
A.				
R.				
PE.				
G.				
TR.	4694			

Date Comp.

MART SEP 5 '56 8-28-56 85/8
 265/200 @ 403000
 @ 4115 SEP 19 '56
 DST 4484-4550 1hr rec 6'
 @ Md BHP 23 DST 4552-
 4694 1hr rec 5' Md BHP 28

DEA