

Barber

KANSAS


SECTION 31 TOWNSHIP 33 RANGE 12W

WELL NO. #1 Hall "I"

COMPANY Petr. Inc.

NORTH

12

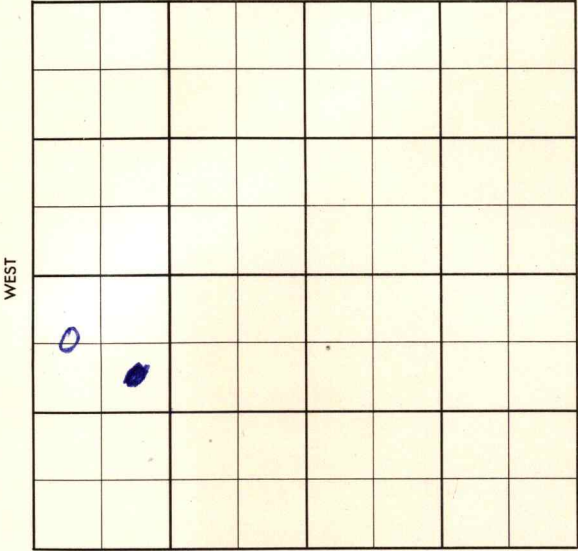

SOUTH

County Barber Elev. 1541 RT, 1539 DF
 Sec. 31 Twp. 33 Rge. 12W
 Company Petroleum Inc.
 Farm Name Hall "I" No. 1

TOPS	DEPTH	LOG	DATUM	Loc. in Sec.
Anh. <u>Deep</u>	<u>3568</u>			<u>C W 1/4 NE SW</u>
Tr.				
H.	<u>3751</u>			Geol.
Tr.				
Dg.	<u>3895</u>			Contr. <u>Garvey</u>
Bl.				
L.	<u>3931</u>			Pool <u>Driftwood</u>
K.C.				
B.K.C.	<u>4407</u>			<div style="border: 1px dashed black; padding: 10px; width: fit-content; margin: 0 auto;"> <p>COMPLETE</p> </div>
Ce.				
C.				
M.	<u>4536</u>			
M.				
K.				
Mz.				
Me.				
V.				
S.				
S.				
A.				
R.				
PE.				
G.				
T.D.	<u>4640</u>			

Date Comm. 5-19-56 JUL 1 1 1956

8" @ 278/250 drlp. 2220 MAY 29 '56

4049 JUN 6 '56

DST 4198-4300 up 1 hr, 1190 MSK

To. Gas, No Pres. DST 4415-25 up 90'

30' mud, BHP 0, DST 4539-91

up 10 min - Gas in 1/4 in up 5, 700'

10 min Rec. 70' G.C.M. BHP 1750/30

DST-4288, 4211 - fluid 5" 4431-1258

WOC JUN 13 '56 PF 60 & 4537-63, N.S.

County Barber Elev. _____
 Sec. 31 Top. 33 Rgs. 12W
 Company Petroleum Inc.
 FarmName Hall "I" No. 1

TOPS	DEPTH	LOG	DATUM
Anh.			
Tp.			
H.			
Tr.			
Dg.			
Bl.			
L.			
K.C.			
B.K.C.			
Ce.			
C.			
M.			
M.			
K.			
Mz.			
Mq.			
V.			
S.			
S.			
A.			
R.			
PE.			
G.			
T.D.			


Loc. in Sec. C W $\frac{1}{2}$ NE SW

Geol. _____
 Contr. Garvey

Pool Driftwood

FIRST REPORT
 0
 MAY 23 '56

Date Comm. 5-19-56
8" @ 278/250 drlg. 2220

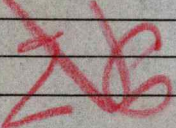6001 P. C. YAM
 R. C. R.


Co.
Lse.
No.
Sec.
T.
R.