

KANSAS

Barber

Section 17 Township 33 Range 12W

Well No. 1 Boggs "C"

Company Skelly

NORTH

						0	

SOUTH

WEST

EAST

KANSAS

Barber County

Sec. 17 Twp. 33 R. 12W

Well No. #1 Boggs "C" Farm

Skelly Company
Medicine Lodge


990 Ft. from N. Line

 Ft. from S. Line

990 Ft. from E. Line

 Ft. from W. Line

SW NE NE

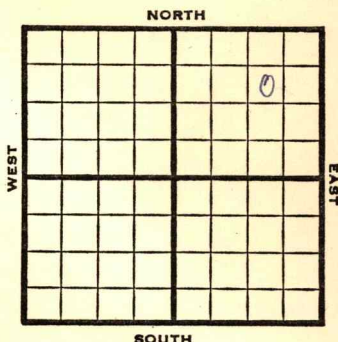

1946

Elev. 1515

REPORT

5/1	Location
5/7	RUR
5/14	10" @ 427 WOC
5/21	Drlg 3085'
5/29	Lans 3860 Drlg. 4230'
6/5	Miss 4408 Viola 4596 TD 4735'
6/12	Simp sd 4802 Sand 4807 TD 4827 DST 4816-27, open 3/4 hr 670,000 gas 300' oil & 90' oil cut mud 7" @ 4876 39.0 Gr.
6/18	Miss 4412 Viola 4699 Simp sd 4806, corrected TD 4831' Flow 15 oil in 10 hrs.
6/26	TD 4844' 80 qts 4824-42 CO
7/3	Flow 47½ oil in 24 hrs.
7/3	" " "
7/16	" " "
7/23	" " "
7/30	" " "

OVER

1946

8/6 Flow $27\frac{1}{2}$ oil in 24 hrs

8/14 Simp. 4811

7" @ 4820

TD 4831

Flow 45 oil plus 5% wtr.

Grav. 39.0

COMPLETED

KANSASKansas Pool Name Medicine LodgeMap No. 61 Sec. 17 Twp. 33 R. 12WWell No. 1 Boggs "C"Skelly


Company

FIRST REPORT

Contractor

SW NE NE

SECTION PLAT

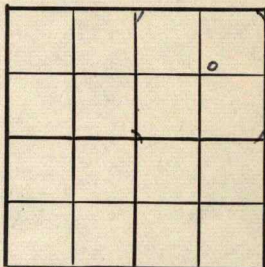990 Ft. from N. Line

Ft. from S. Line

990 Ft. from E. Line

Ft. from W. Line

Barber CountyLocation X

Rig up

Drilling and Remarks:

RECORDCased in., ft.Sand Gas Oil Total Depth **PRODUCTION**1st 24 hrs. Nat. 1st 24 hrs. after shot Gas Cu. Ft.Dry Hole Abandoned

Date

MAY 1 1946 19S. J. LEWIS

Scout

KANSAS

Kansas Pool Name BoggsMap No. 61 Sec. 17 Twp. 33 R. 12WWell No. 1 Boggs "C"Skelly Company

COMPLETED

Contractor

SW NE NE

E 1, 15-15
SECTION PLAT990 Ft. from N. Line

			0

 Ft. from S. Line990 Ft. from E. Line Ft. from W. Line

Barber County

Location Rig up

Drilling and Remarks:

Shut 48117" @ 4820Flow 45 oil+5% W.892 ft

RECORD

Cased in., ft.Sand Gas Oil Total Depth 4821

PRODUCTION

1st 24 hrs. Nat. 1st 24 hrs. after shot Gas Cu. Ft.Dry Hole Abandoned

Date

AUG 14 1946

19

S. J. LEWIS

Scout