


KANSAS

Barber countt  
Boggs Pool

Section 17 Township 33 Range 12W

Well No. 4 Boggs "C"

Company Skelly

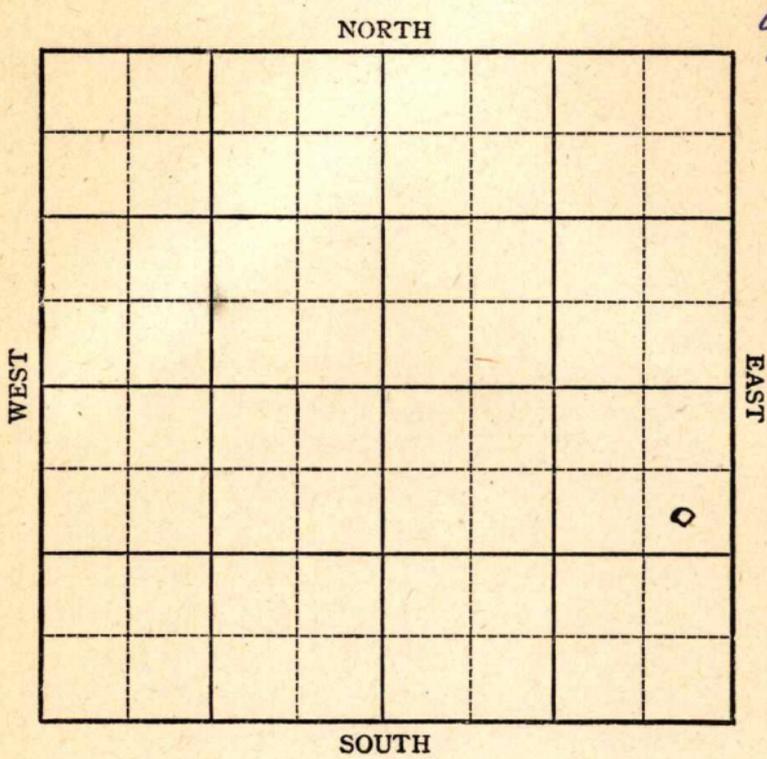

KANSAS

Barber ✓

Sec. 17 Twp. 33 R. 12-W

Well No. #4 Boggs "C" Farm

Skelly Company


Boggs pool

990 Ft. from N. Line

\_\_\_\_\_ Ft. from S. Line

330 Ft. from E. Line

\_\_\_\_\_ Ft. from W. Line

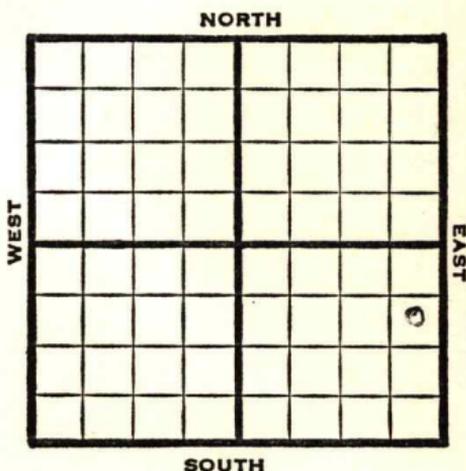

SE NE SE

1947 **Elev. 1491'** REPORT

4/23 R U R

4/29 8" @ 587'  
Drlg 1100'

5/7 Drlg. 3150'

5/13 **Lans 3830'**  
TD 4040'

5/20 Drlg 4660'

5/27 **Miss 4386**  
**Viola 4686**  
**Simpson Sd 4791**  
TD 4835'  
5" @ 4794 RUST

6/3 " " "

6/10 60 qts. 4830-4801'  
3000' oil

6/17 " "

6/25 TD 4835'  
**Simpson Sd 4791'**  
5" @ 4794'  
Abandoned

**ABANDONED**

Map No. 1561 Sec. 17 Twp. 33 R. 12W

Well No. 4 Boggs "C"

Skelly Company

FIRST REPORT

Contractor

SE NE SE

SECTION PLAT

			o

990 Ft. from N. Line

\_\_\_\_\_ Ft. from S. Line

330 Ft. from E. Line

\_\_\_\_\_ Ft. from W. Line

Barber County

Location \_\_\_\_\_

Rig up \_\_\_\_\_

Drilling and Remarks:

R U R

RECORD

Cased \_\_\_\_\_ in., \_\_\_\_\_ ft.

Sand \_\_\_\_\_

Gas \_\_\_\_\_

Oil \_\_\_\_\_

Total Depth \_\_\_\_\_

PRODUCTION

1st 24 hrs. Nat. \_\_\_\_\_

1st 24 hrs. after shot \_\_\_\_\_

Gas \_\_\_\_\_ Cu. Ft.

Dry Hole \_\_\_\_\_

Abandoned \_\_\_\_\_

Date

APR 23 1947 19

S. J. LEWIS Scout

Map No. 61 Sec. 17 Twp. 33 R. 12W

Well No. 4 Boggs "C"

Skelly Company

**ABANDONED**

Contractor

SE NE SE


*E. 11491*  
SECTION PLAT

990 Ft. from N. Line

\_\_\_\_\_ Ft. from S. Line

330 Ft. from E. Line

\_\_\_\_\_ Ft. from W. Line

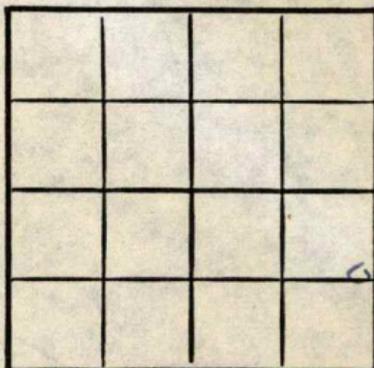

Barber County

Location \_\_\_\_\_

Rig up \_\_\_\_\_

Drilling and Remarks:

*Sample 84791  
5' (64794*

**RECORD**

Cased \_\_\_\_\_ in., \_\_\_\_\_ ft.

Sand \_\_\_\_\_

Gas \_\_\_\_\_

Oil \_\_\_\_\_

Total Depth 4835

**PRODUCTION**

1st 24 hrs. Nat. \_\_\_\_\_

1st 24 hrs. after shot \_\_\_\_\_

Gas \_\_\_\_\_ Cu. Ft.

Dry Hole \_\_\_\_\_

Abandoned \_\_\_\_\_

Date

JUN 25 1947 19

S. J. LEWIS Scout