


KANSAS

Section 17 Township 33 Range 12W

Well No. 6 Boggs "C"

Company Skelly

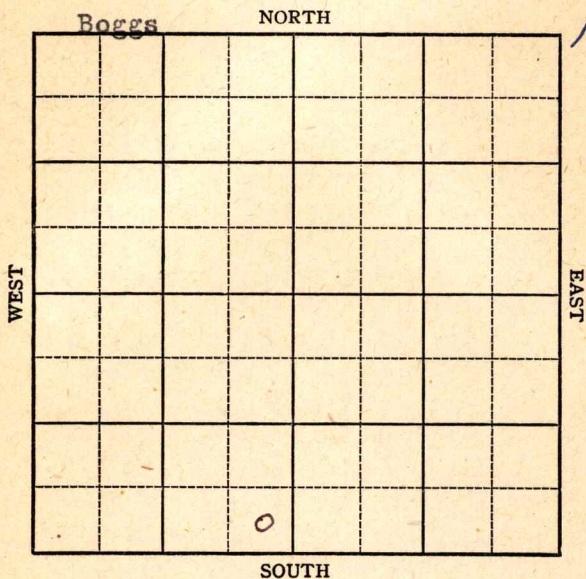

KANSAS Barber

Sec. 17 Twp. 33 R. 12W

Well No. #6 Boggs "C" Farm

Skelly Company


Boggs

 Ft. from N. Line

330 Ft. from S. Line

330 Ft. from E. Line

 Ft. from W. Line

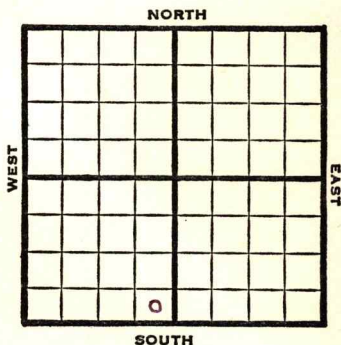

SE SW

1947

Elev. 1526' REPORT

7/23 Location

7/29 RUR

8/6 8" @ 1705'
WOC

8/13 Drlg. 3290'

8/20 Drlg 4250'

8/27 Drlg. 4740'

9/3 **Lansing 3869' ;**
Mississippi 4438' ;
Viola 4728' ;
Simp 4825' ;
TD 4885'
5" @ 4830'


9/10 Flow 392 bbls oil thru
28/64" choke

9/17 **Simp. Sd. 4826' ;**
5" @ 4830'
Flow 461 Pot
Gr. 43°
Total Depth 4885'

COMPLETED

KansasMap No. _____ Sec. 17 Twp. 33 R. 12WWell No. 6 Boggs "C"_____
Skelly CompanyFIRST REPORT Contractor

SE SW

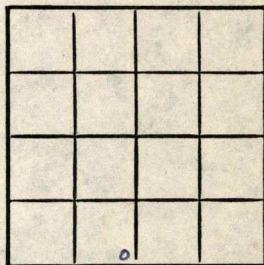SECTION PLAT_____
Ft. from N. Line330 Ft. from S. Line330 Ft. from E. Line_____
Ft. from W. LineBarber CountyLocation X

Rig up _____

Drilling and Remarks:

RECORD

Cased _____ in., _____ ft.

Sand _____

Gas _____

Oil _____

Total Depth _____

PRODUCTION

1st 24 hrs. Nat. _____

1st 24 hrs. after shot _____

Gas ~~1~~ _____ Cu. Ft.

Dry Hole _____

Abandoned _____

Date

JUL 23 1947

19

S. J. LEWIS

Scout

Map No. 61 Sec. 17 Twp. 33 R. 12W

Well No. 6 Boggs "C"

Skelly


Company

COMPLETE

Contractor

SE SW

E11526
SECTION PLAT

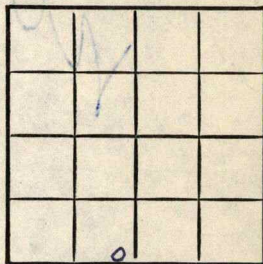

 Ft. from N. Line

330 Ft. from S. Line

330 Ft. from E. Line

 Ft. from W. Line

Barber County

Location

Rig up

Drilling and Remarks:

*Comp Sol 4826
5" C 4830*

Flow 461 Pst

40 2 Gr

RECORD

Cased in., ft.

Sand

Gas

Oil

Total Depth 4885

PRODUCTION

1st 24 hrs. Nat.

1st 24 hrs. after shot

Gas Cu. Ft.

Dry Hole

Abandoned

Date

SEP 17 1947

19

S. J. LEWIS

Scout