

Section 17 Township 33 Range 12W


Well No. 8 Boggs "C"

Company Skelly

Boggs

NORTH

6

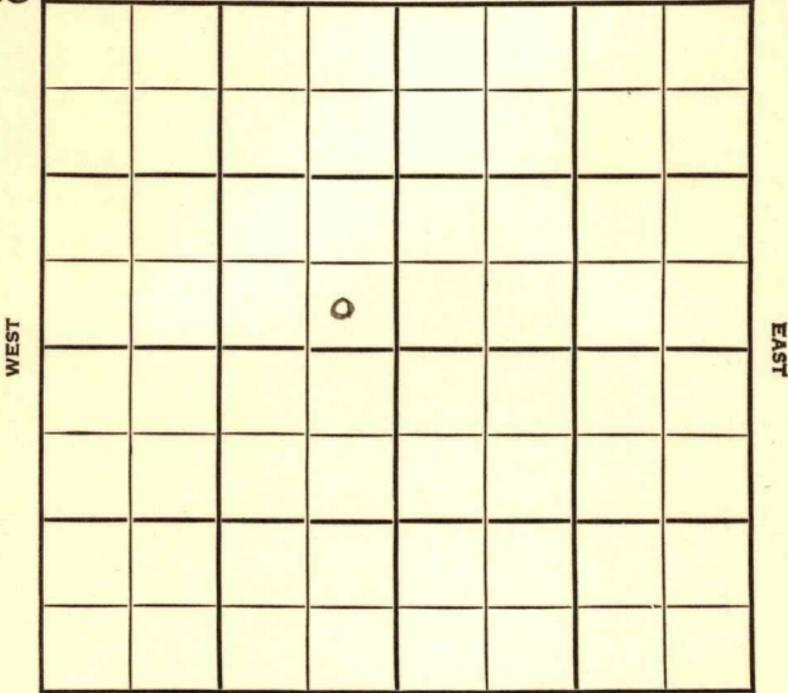

SOUTH

Sec. 17 Twp. 33 R. 12W

Well No. #8 Boggs "C" Farm
Skelly Company

Boggs Pool


990 Ft. from N. Line

_____ Ft. from S. Line

330 Ft. from E. Line

_____ Ft. from W. Line

SE NE SW

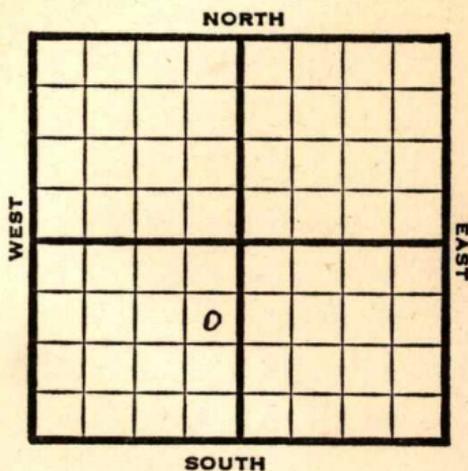

1947

Elev. 1519' REPORT

- 11/5 Derrick
- 11/12 RUR
- 11/19 8" @ 1640'
Drlg. 2565'
- 11/25 Drlg. 3850'
- 12/3 Drlg. 4575'
- 12/10 Lansing 3872
Mississippi 4421
Viola 4716
Simpson 4824-78
TD 5" @ 4811 RUST
- 12/17 Flow 80 bbls. oil PH 8 hrs.
- 12/30 "
- 1948
- 1/7 "
- 1/14 "
- 1/21 "
- 1/28 Simp. Sd. 4824'
5" @ 4811'
Pump 517 Pot
44.0 Gr.
TD 4878'
Comp.

COMPLETED

Map No. _____ Sec. 17 Twp. 3 3 R. 12W

Well No. 8 Boggs "C"

Skelly Company

FIRST REPORT Contractor

SE NE SW


SECTION PLAT

990 Ft. from N. Line

_____ Ft. from S. Line

330 Ft. from E. Line

_____ Ft. from W. Line

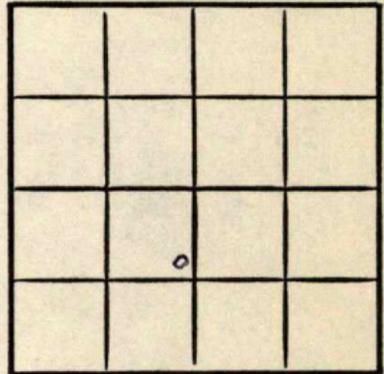

Barber County

Location _____

Rig up _____

Drilling and Remarks:

Derrick

RECORD

Cased _____ in., _____ ft.

Sand _____

Gas _____

Oil _____

Total Depth _____

PRODUCTION

1st 24 hrs. Nat. _____

1st 24 hrs. after shot _____

Gas _____ Cu. Ft.

Dry Hole _____

Abandoned _____

Date

NOV 5 1947 19 _____

S. J. LEWIS Scout

Map No. 61 Sec. 17 Twp. 33 R. 12W

Well No. 8 Boggs "C"

Skelly Company

COMPLETE

Contractor

SE NE SW


E. 1519
SECTION PLAT

990 Ft. from N. Line

_____ Ft. from S. Line

330 Ft. from E. Line

_____ Ft. from W. Line

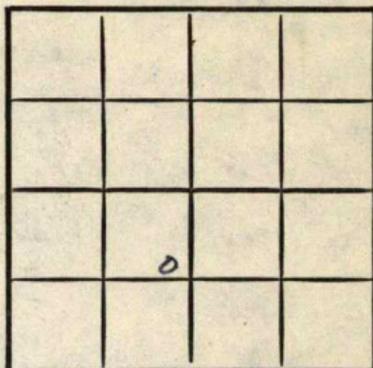

Barber County

Location _____

Rig up _____

Drilling and Remarks:

Comp. Sub 4824

5' @ 4811

Pump 517 P & X

44 3/4

RECORD

Cased _____ in., _____ ft.

Sand _____

Gas _____

Oil

Total Depth 4878

PRODUCTION

1st 24 hrs. Nat. _____

1st 24 hrs. after shot _____

Gas _____ Cu. Ft.

Dry Hole _____

Abandoned _____

Date

JAN. 28 1948 19

S. J. LEWIS Scout