


Section 17 Township 33 Range 12W
 Well No. #10 Boggs "C"
 Company Skelly

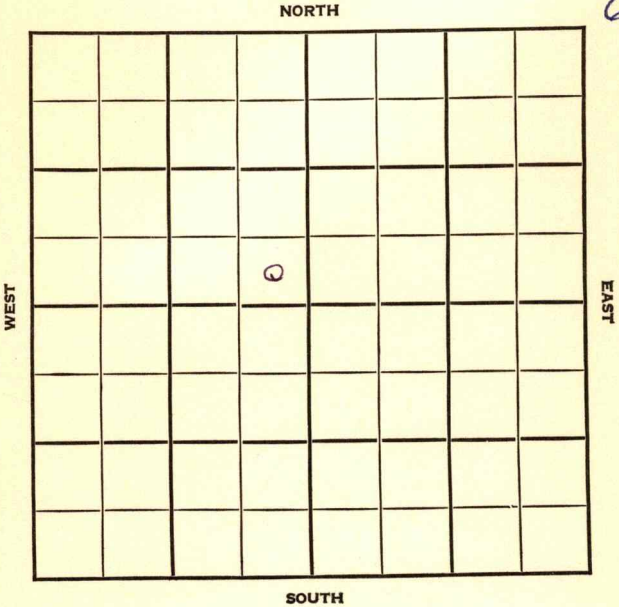

KANSAS

Barber

Sec. 17 Twp. 33 R. 12W

Well No. #10 Boggs "C" Farm

Skelly Company

Boggs Pool


Ft. from N. Line

330' Ft. from S. Line

330' Ft. from E. Line

Ft. from W. Line

SE NW

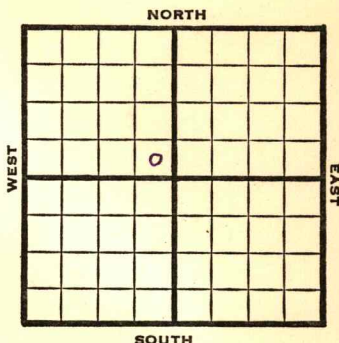

1948	Eli 1513' REPORT
7/8	Location
7/14	"
7/21	Drlg 1400'
7/28	8"@ 1661'
	Drlg 2490'
8/4	4290' SD
8/11	Drlg 4750'
8/18	Lansing 3845'
	Mississippi 4414'
	Viola 4717'
	Simpson Sand 4809'
	TD 4870
	5"@ 4809'
8/25	"
9/1	TD 4870 fsg swab
9/8	120 qts 4816-64 CO
9/14	"
9/21	"
9/29	"
10/6	1000' oil
10/13	"
10/19	"
10/26	"

OVER

1948
11/3 1080' oil

11/10 "

11/16 "

11/23 "

12/1 TD 4870'

Simp 4809'

5"@ 4809'

Pump 195 Oil Pot

41° Gr

Comp

COMPLETED

Map No. _____ Sec. 17 Twp. 33 R. 12W

Well No. 10 Boggs "C"

Skelly Company

FIRST REPORT

Contractor

SE NW

SECTION PLAT

_____ Ft. from N. Line

330 Ft. from S. Line

330 Ft. from E. Line

_____ Ft. from W. Line

Barber County

Location X

Rig up _____

Drilling and Remarks:

RECORD

Cased _____ in., _____ ft.

Sand _____

Gas _____

Oil _____

Total Depth _____

PRODUCTION

1st 24 hrs. Nat. _____

1st 24 hrs. after shot _____

Gas _____ Cu. Ft.

Dry Hole _____

Abandoned _____

Date

JUL 8 1948 19 S. J. LEWIS Scout

Map No. 61 Sec. 17 Twp. 33 R. 12W

Well No. 10 Boggs "C"

Skelly Company

COMPLETE

Contractor

SE NW

E11513
SECTION PLAT

 Ft. from N. Line

330 Ft. from S. Line

330 Ft. from E. Line

 Ft. from W. Line

Barber County

Location

Rig up

Drilling and Remarks:

Drill 4809

5104809

Pump 1950/10/11

4128

RECORD

Cased in., ft.

Sand

Gas

Oil ✓

Total Depth 4870

PRODUCTION

1st 24 hrs. Nat.

1st 24 hrs. after shot

Gas Cu. Ft.

Dry Hole

Abandoned

Date

DEC 1 1948 19

S. J. LEWIS

Scout