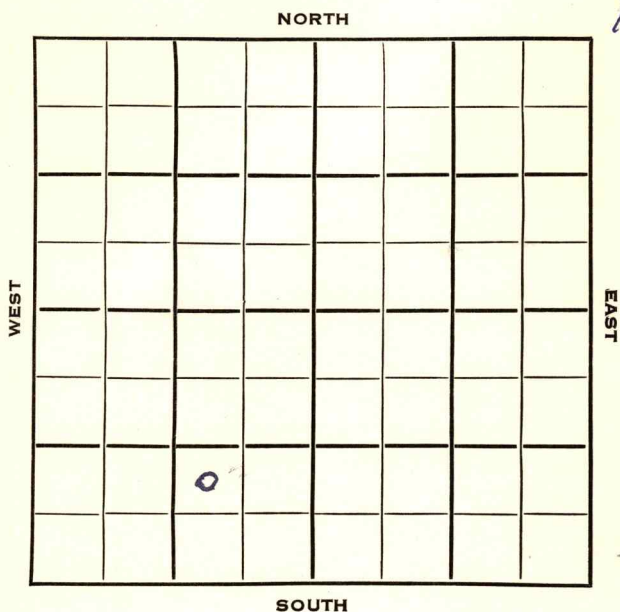


Section 17 Township 33 Range 12WWell No. 16 Boggs "C"Company Skelly Oil

SEC.	TWP.	R.
17	33	12 W ✓
WELL NO.		
# 16 Boggs "C"		
COMPANY		FARM
Skelly Oil		
CONTRACTOR		

Boggs Pool


_____ Ft. from N. Line

990 _____ Ft. from S. Line

990 _____ Ft. from E. Line

_____ Ft. from W. Line

NW SE SW

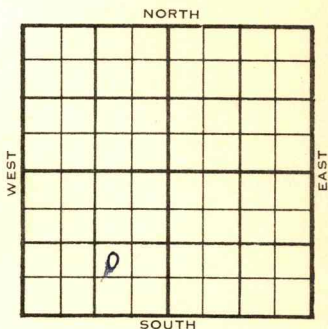

	ELEVATION	REPORT
1954	1584'	

3/3 Location

3/10 8" @ 556' w/1997 sks

3/17 Elgin 3645'

DST 3642'-60' 1 hr, 3' SW 155#

Heeb 3754'

Drlg 4085'

3/24 Drlg 4628'

4/7 Spud 3-3-54 Oil well TD 4952

8" @ 556 Elgin 3645'

DST 3642-60 open 1 hr rec 3' SW

155# Heeb 3754 Lans. 3934

B KC 4390 Miss. 4495 Kh. 4686

Chat 4747 Meisner 4791 Viola 4795

Simp shale 4891 Simp. sd. 4905'

TD 4952 5" @ 4952 CO to 4932

54/4911-20 S/180 BO 14 hr.

P/88 BO 12 hr.

Comp. 240 BOPD

COMPLETED

County Barber State Kansas
 Sec. 17 (Blk.) 33 (Sur.) 12W Map No.
 Operator Skelly Oil
 Well No. 16 Farm Boggs "C"
 Elev. 1584 Location NW SE SW



990 Ft. From S Line SW
990 Ft. From E Line Quarter
 Ist. Report
 Completion APR 7 1954
 Remarks Boggs Pool
 Spudding Date 3-3-54

Drlg. Data Oil well TD 4952
8" @ 556 Elgin 3645 DST 3642-60
open 1 hr. Rec. 3' sw 155# Heeb. 3754
Lans. 3934 B KC 4390 Miss. 4495
Kh. 4686 Chat 4747 Meisner 4791
Viola 4795 Simp. sh. 4891 Simp. sd.
4905 TD 4952 5" @ 4952 CO to 4932
54/ 4911-20 S/ 180 bo 14 hr.
P/ 88 bo 12 hr. Comp. 246 bopd

J. G. McGEHEE

