


Section 13 Township 33 Range 12 W

Well No. # 1 Len Groendycke

Company Skelly Oil

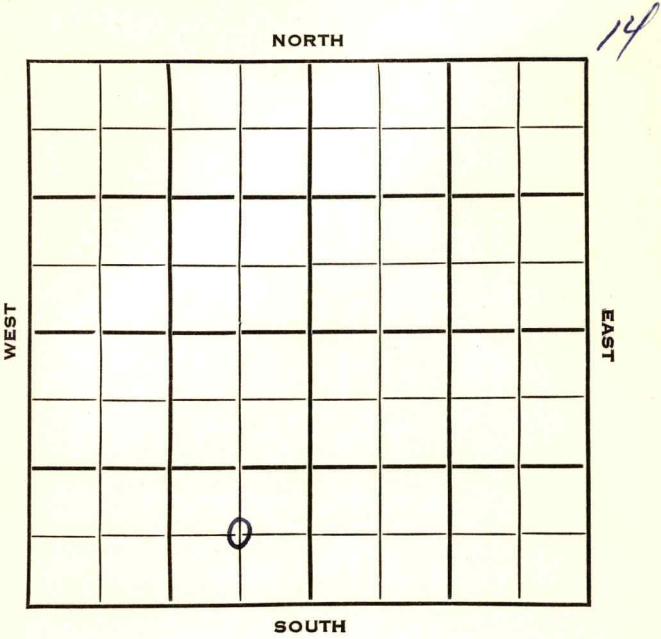

Barber

KANSAS

Sec. 13 Twp. 33 R. 12 WWell No. # 1 Len Groendycke FarmSkelly Oil Company


Contractor

Ft. from N. Line

660 Ft. from S. Line660 Ft. from E. Line

Ft. from W. Line

C SE SW

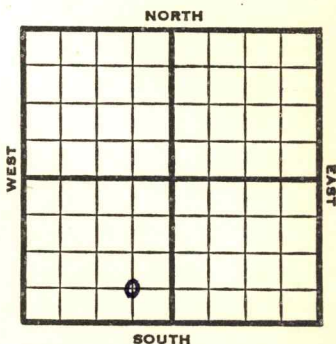

1953

Elev. 1437'

REPORT

8/5

Location

8/12

8" @ 517'
Drlg 2907'

8/19

Drlg 3900'

9/23

N.R.

11/4

"

11/11

Spud 8-3-53

D&A

TD 4557'

8" @ 517'

Elgin sd. 3452'

DST 3441-75, opn 1 $\frac{1}{4}$ hrs., rec. 3' mud

Heeb 3616', Tonganoxie sd. 3712'

DST 3710-22, opn 1 $\frac{1}{2}$ hrs., rec. 2900'
sw, 1525#

Miss 4470'

DST 4467-80, opn 1 hrs., rec. 20'
sgcm, 60' sogcm, 1320#DST 4489-4557', opn 1 hr., rec. 2350'
sgcsw, 1793#

5" @ 4557'

TD 4557'

CO to 4527

90/4473-88, 5 go 14 hrs., 250^A

S/4 bo 2 bw

OVER

(Information Brought Forward)

1953

11/11

Sd-oil-frac

F/26 bo 104 bw 13 hrs.

CO to 4484'

88/4474-84

B/1 gwph 12 hrs., 500A

100 bw 7 hrs.

24/4484-88, 23/4488-92

Sd-frac, dry

30/4492-97

Sd-frac


S/14 bo 21 bw 7 hrs.

P/5 bo 98 bw 20 hrs.

P/100 bw 24 hrs.

D&A

ABANDONED

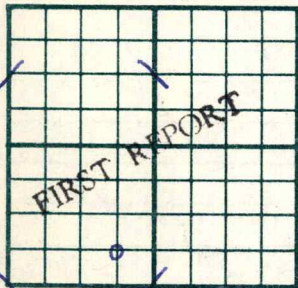County Barber State KansasSec. 13 (Blk.) 33 (Sur.) 12W Map No.Operator Skelly OilWell No. 1 Farm Len GroendyckeElev. Location C SE SW660 Ft. From S Line SW660 Ft. From E Line Quarter1st. Report AUG 5 1953

Completion

Remarks

Spudding Date

Drlg. Data

Location

J. G. McGEHEE

County Barber State KansasSec. 13 (Blk.) 33 (Sur.) 12W Map No.Operator Skelly OilWell No. 1 Farm Len GroendyckeElev. 1437 Location C SE SW660Ft. From S Line SW660Ft. From E Line Quarter1st. ReportCompletion NOV 11 1953RemarksSpudding Date 8-3-53Drlg. Data D & A TD 45578" @ 517 Elgin sd. 3452 DST 3441-75open 1 $\frac{1}{4}$ hr. Rec. 3' mud Heeb. 3616Tonganoxie sd. 3712 DST 3710-22open $\frac{1}{2}$ hr. Rec. 2900' sw 1525#Miss. 4470 DST 4467-80 open 1 hr.Rec. 20'sgcm 60' sogcm 1320#DST 4489-4557 open 1 hr. Rec. 2350'sgcsw 1793# 5" @ 4557 TD 4557CO to 4527 90/ 4473-88 5 go 14 hr.250 A S/ 4 bo 2 bw sd-oil-fracF/ 26 bo 104 bw 13 hr. CO to 448488/ 4474-84 B/ 1 gwph 12 hr. 500 A100 bw 7 hr. 24/ 4484-88 23/ 4488-92sd-frac dry 30/ 4492-97 sd-frac

J. G. McGEHEE

Drlg. Data

S/ 14 bo 21 bw 7 hr. P/ 5 bo 98 bw

20 hr. P/ 100 bw 24 hr.

Misc.
Pierce Map
France Map
Tracing
Land Wall Map
Land Small Map
Scout Cards

3

18

NOV 16 1963