


Section 13 Township 33 Range 12W

Well No. #2 Harbaugh (C)

Company Skelly Oil

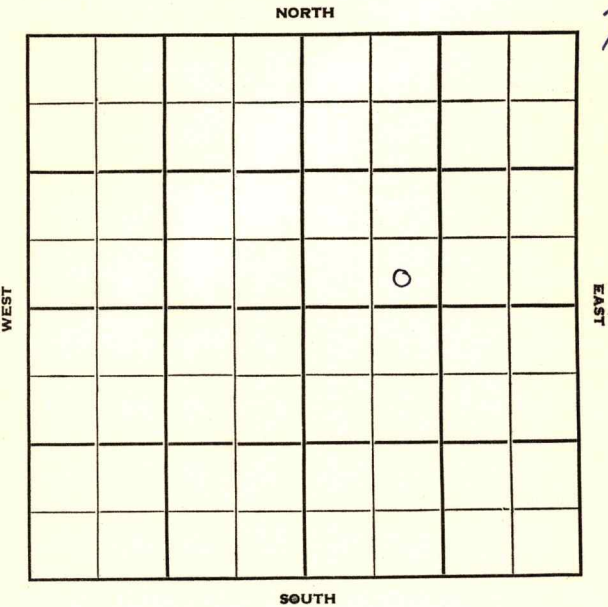

Barber

KANSAS

Sec. 13 Twp. 33 R. 12W

Well No. #2 Harbaugh (C) Farm

Skelly Oil

Company

Contractor

Ft. from N. Line

330'


Ft. from S. Line

Ft. from E. Line

990'

Ft. from W. Line

SE SW NE

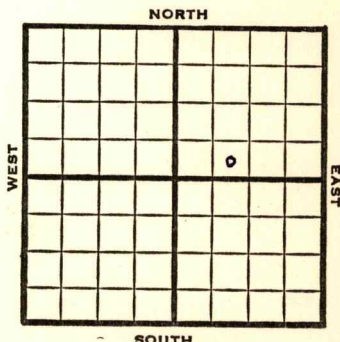

1951

Elev. 1403' REPORT

9/12

Location

11/7

Spud 10-7-51

D&A TD 4830

8" @ 575 Doug 3665

DST 3659-71 opn 1 hr

Rec. 60' mud & wtr

Lans. 3735

DST 3646-3960 opn 1 hr Rec. 2745' wtr

Miss 4398

DST 4426-35 opn 50min est. 50,000

gas 250' gcm DST 4435-70 opn

50 min. Rec. 570' gcm & wtr

Viola 4732 Simp 4815

Sand 4820

DST 4813-30 ppn 1/2 hr Rec. 175' mud &

sw D&A

ABANDONED

County **Barber** State **Kansas**

Sec. **13** (Blk. Twp.) **33** (Sur. Rge.) **12W** Map No.

Operator **Skelly Oil**

Well No. 2 Farm Harbaugh (C)

[illegible]

FIRST REPORT

330 Ft. From S Line NE

990 Ft. From W Line Quarter

1st. Report SEP 12 1951

Completion

Remarks

Spudding Date _____

Drlg. Data

Location

J. E. TYRA

County Barber State Kansas
 Sec. 13 (Blk.) 33 (Sur. Rge.) 12W Map No. _____
 Operator Skelly Oil
 Well No. 2 Farm Harbaugh "C"
 Elev. 1403 Location SE SW NE



330 Ft. From S Line NE
990 Ft. From W Line Quarter

1st. Report

Completion NOV 7 1951

Remarks

Spudding Date 10-7-51

Drlg. Data D & A TD 4830

8" @ 575 Doug. 3665 DST 3659-71

open 1 hr. Rec. 60' mud & water Lans. 3735

DST 3646-3960 open 1 hr. Rec. 2745' water

Miss. 4398 DST 4426-35 open 50 min.

est. 50,000 gas 250' gcm DST 4435-70

open 50 min. Rec. 570' gcm & water

Viola 4732 Simp. 4815 sand 4820

DST 4813-30 open $\frac{1}{2}$ hr. Rec. 175' mud &

sw D & A

J. E. TYRA