


## FORM 51 IOM 12-46 PETROL

Section 16 Township 33 Range 12-N

Company Cities Service

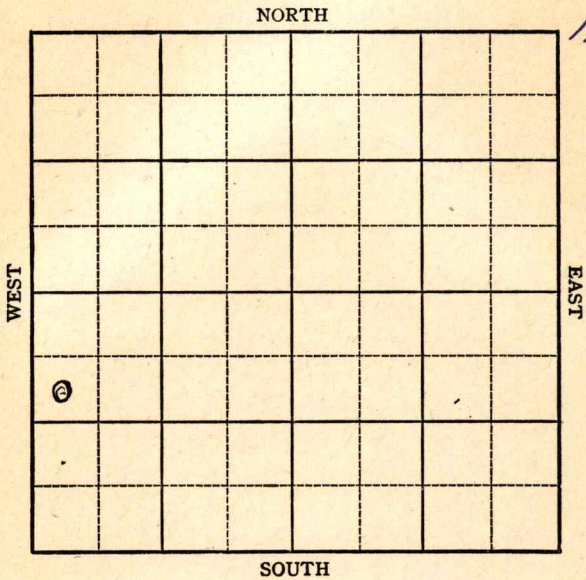

Boggs Pool ✓

KANSAS

Sec. 16 Twp. 33 R. 12-W

Well No. 2 Boggs "B" Farm

Cities Service Company


SW NW SW

990 Ft. from N. Line

\_\_\_\_\_ Ft. from S. Line

\_\_\_\_\_ Ft. from E. Line

330 Ft. from W. Line

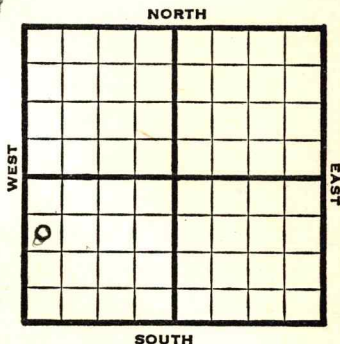

Barber County

1947

*1543*

REPORT

2-12 - R UR

2/19 8" @ 530'  
Drlg 406'

3/4 **Lans 3886**  
**Miss 4435'**  
**Viola 4755**  
**Simp 4848**  
**Sand 4878'**  
TD 4903  
Run 5"

3/11 **Viola 4750'** corrected  
TD 4903'  
Flow 115 bbls oil in 4 hrs

3/26 **Simp. 4848'**  
5" @ 4879'  
Bom. & Pot. 943  
37.0 Gr.  
TD 4903'

**COMPLETED**

Map No. 61 Sec. 16 Twp. 33 R. 12WWell No. 2 Boggs "B"

Cities Service


Company

FIRST REPORT

Contractor

SW NW SW

## SECTION PLAT

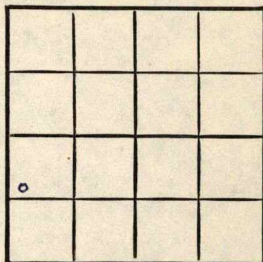990 Ft. from N. Line       Ft. from S. Line       Ft. from E. Line330 Ft. from W. Line

Barber County

Location

Rig up

Drilling and Remarks:

R U R

## RECORD

Cased        in.,        ft.Sand       Gas       Oil       Total Depth       

## PRODUCTION

1st 24 hrs. Nat.       1st 24 hrs. after shot       Gas        Cu. Ft.Dry Hole       Abandoned       

Date

FEB 12 1947

19

S. J. LEWIS

Scout

Map No. 1561 Sec. 16 Twp. 33 R. 12W

Well No. 2 Boggs "B"

Cities Service

Company

COMPLETE

Contractor

SW NW SW

17,1548  
SECTION PLAT

990 Ft. from N. Line

       Ft. from S. Line

       Ft. from E. Line

330 Ft. from W. Line

|   |  |  |  |
|---|--|--|--|
|   |  |  |  |
|   |  |  |  |
|   |  |  |  |
| 0 |  |  |  |
|   |  |  |  |

Barber County

Location                                 

Rig up                                 

Drilling and Remarks:

*Shut 4848*  
*5104879*  
*Barn 188943*

RECORD

Cased        in.,        ft.

Sand                                 

Gas                                 

Oil                                 

Total Depth 4920

PRODUCTION

1st 24 hrs. Nat.                                 

1st 24 hrs. after shot                                 

Gas                                  Cu. Ft.

Dry Hole                                 

Abandoned                                 

*37294*

Date

MAR 26 1947

19

S. J. LEWIS Scout