

KANSAS


Barber

O.W.W.O.

Section 16 Township 33 Range 12W

Well No. 3 Boggs "B"

Company Cities Service
Boggs

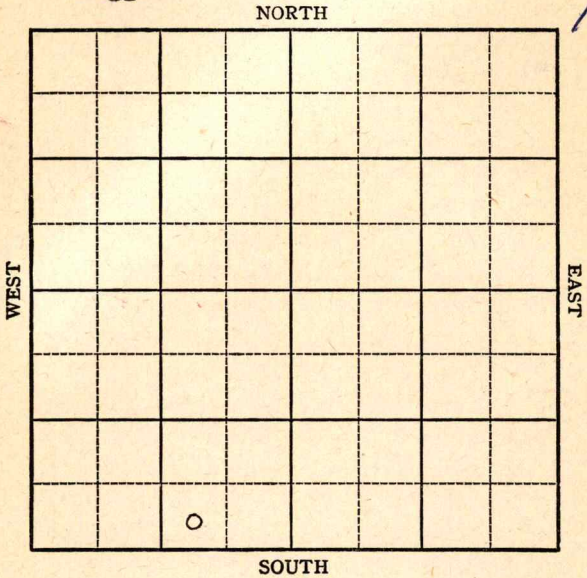

O.W.W.O.

Barber

KANSAS

Sec. 16 Twp. 33 R. 12W

Well No. #3 Boggs "B" Farm

Cities Service Company
Boggs


 Ft. from N. Line

330 Ft. from S. Line

990 Ft. from E. Line

 Ft. from W. Line

SW SE SW

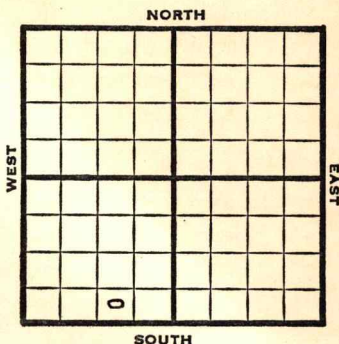

1947 Elev. 1527 REPORT

4/2 Surface hole.

4/9 8" @ 463'
Drlg. 2450'

4/15 Drlg. 4123'

4/23 Simpson 4892'
TD 4898'
Run Csg.

4/29 5" @ 4900'
Simpson sand 4905 corrected
TD 4019'

5/7 " " "

5/13 " " 2

5/20 " " "

5/28 Simp sd 4887
5" @ 4888
TD 4901'

ABANDONED

OVER

1952

O.W.W.O.

5/28

Douglas 3798 Lans. 3868
Simp. 4887 OTD 4901'
x~~4~~ 5" @ 4888' D&A PB 3945
8/ 3868-72 Sq. off 45/ 3870-82
1000 A 5/120 BW 7 hrs. PB 3827
7/ 3740-46 G&M sq off CO 3823
23/ 3740-54 1600' wtr. $\frac{1}{2}$ hrs.
PB 3731 17/ 3708-24 7/ 3680-86
20/3641-60 4/ 3665-68 6/ 3583-88
9/ 3591-3600 8/ 3473-80 30 gal
wph D&A

FIRST REPORT

+

ABANDONED

Kansas

Map No. K61 Sec. 16 Twp. 33 R. 12WWell No. 3 Boggs "B"

Cities Service


Company

FIRST REPORT

Contractor

SW SE SW

SECTION PLAT

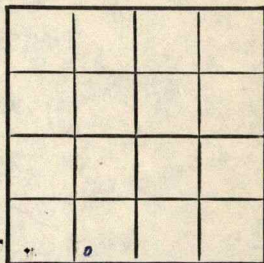

Ft. from N. Line

330 Ft. from S. Line990 Ft. from E. Line

Ft. from W. Line.

Barber County

Location

Rig up

Drilling and Remarks:

surface hole

RECORD

Cased _____ in., _____ ft.

Sand _____

Gas _____

Oil _____

Total Depth _____

PRODUCTION

1st 24 hrs. Nat. _____

1st 24 hrs. after shot _____

Gas _____ Cu. Ft.

Dry Hole _____

Abandoned _____

Date

APR 2 1947 19

S. J. LEWIS Scout

Kansas

Map No. K 61 Sec. 16 Twp. 33 R. 12WWell No. 3 Boggs "B"


Cities Service

Company

ABANDONED

Contractor

SW SE SW

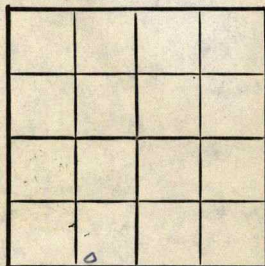E 11027
SECTION PLAT

_____ Ft. from N. Line

330 Ft. from S. Line990 Ft. from E. Line

_____ Ft. from W. Line

Barber County

Location _____

Rig up _____

Drilling and Remarks:

Simp Sol 4887
5 c 4888

RECORD

Cased _____ in., _____ ft.

Sand _____

Gas _____

Oil _____

Total Depth 4901

PRODUCTION

1st 24 hrs. Nat. 222

1st 24 hrs. after shot _____

Gas _____ Cu. Ft.

Dry Hole _____

Abandoned _____

Date

MAY 28 1947 19

S. J. LEWIS

Scout

