


Section 16 Township 33 Range 12 W

Well No. 4 Boggs "B"

Company Cities Service

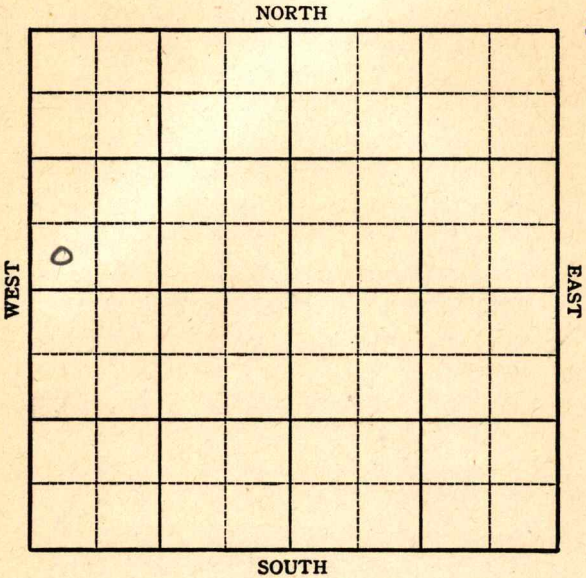

KANSAS

Barber



Sec. 16 Twp. 33 R. 12-W

Well No. #4 Boggs "B" Farm

Cities Service Company


Boggs

 Ft. from N. Line

330 Ft. from S. Line

 Ft. from E. Line

330 Ft. from W. Line

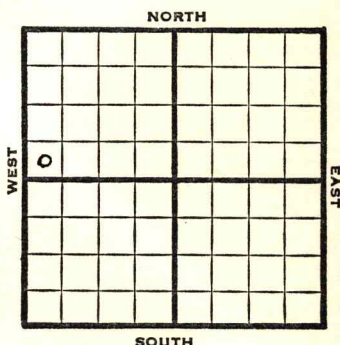

SW NW

1947 **Elev. 1475'** REPORT

5/14 Location

5/20 8" @ 595'
Drlg 2280'

5/27 Drlg. 3940'

6/3 **Lansing 3875**
Miss 4398
Viola 4669
Simpson 4775
Drlg. 4815'

6/10 TD 4835' SG

6/18 **Simp. sd. 4803'**
TD 4835'

ABANDONED

Map No. 1561 Sec. 16 Twp. 33 R. 12WWell No. 4 Boggs "B"

Cities Service

Company

FIRST REPORT

Contractor

SW NW

SECTION PLAT

_____ Ft. from N. Line

330 Ft. from S. Line

_____ Ft. from E. Line

330 Ft. from W. Line

6			

Barber County

Location X

Rig up _____

Drilling and Remarks:

RECORD

Cased _____ in., _____ ft.

Sand _____

Gas _____

Oil _____

Total Depth _____

PRODUCTION

1st 24 hrs. Nat. _____

1st 24 hrs. after shot _____

Gas _____ Cu. Ft.

Dry Hole _____

Abandoned _____

Date

MAY 14 1947

19

S. J. LEWIS

Scout

Map No. 61 Sec. 16 Twp. 33 R. 12W

Well No. 4 Boggs

Cities Service Company

ABANDONED

Contractor

SW NW


E1.1475
SECTION PLAT

 Ft. from N. Line

330 Ft. from S. Line

 Ft. from E. Line

330 Ft. from W. Line

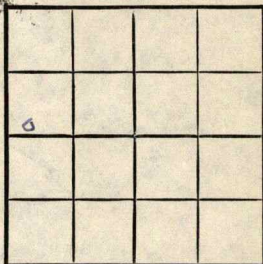

Barber County

Location

Rig up

Drilling and Remarks:

Drup E1.1475

RECORD

Cased in., ft.

Sand

Gas

Oil

Total Depth 4835

PRODUCTION

1st 24 hrs. Nat.

1st 24 hrs. after shot

Gas Cu. Ft.

Dry Hole

Abandoned

Date

JUN 1 8 1947

19

S. J. LEWIS

Scout