


KANSAS

Barber county

Section 17 Township 33 Range 12-W

Well No. #2 Boggs "C"

Company Skelly

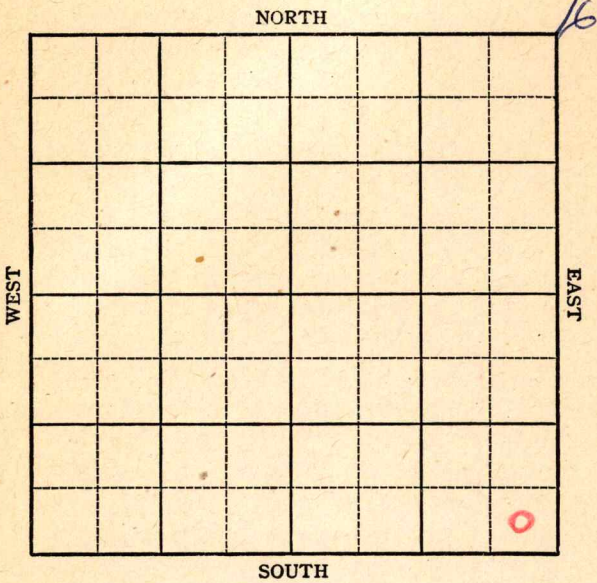

KANSAS

Barber

Sec. 17 Twp. 33 R. 12-W

Well No. #2 Boggs "C" Farm


Skelly Company
Boggs Pool

 Ft. from N. Line

330 Ft. from S. Line

330 Ft. from E. Line

 Ft. from W. Line

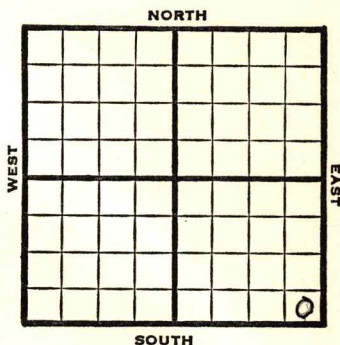

SE/C

REPORT

1947

1528

2/5

R U R

2/12

13" @ 216'
WOC

2/19

8" @ 1645'
WOC

2/26

SD 2190'

3/4

Drlg 3650'

3/11

Drlg 4755'

3/18

Elgin 3563
Lans 3867
Miss 4450
Misner 4726
Viola 4730
Simp sand 4851'
TD 4888
5" @ 4851'
RUST

3/25

TD 4888'
Flow 202 bbls oil in 7 hrs

4/2

" " "

OVER

4/9

Simp 4851

5" @ 4851

Pump & Pot 2518'

Grav. 40


TD 4888'

COMPLETED

Map No. 61 Sec. 17 Twp. 33 R. 12WWell No. 2 Boggs "C"Skelly CompanyFIRST REPORT Contractor

SE/C

SECTION PLAT

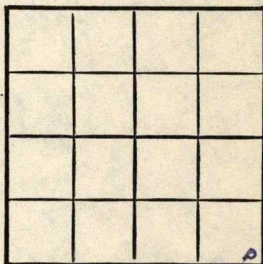 Ft. from N. Line330 Ft. from S. Line330 Ft. from E. Line Ft. from W. LineBarber CountyLocation Rig up

Drilling and Remarks:

R U R

RECORD

Cased in., ft.Sand Gas Oil Total Depth

PRODUCTION

1st 24 hrs. Nat. 1st 24 hrs. after shot Gas Cu. Ft.Dry Hole Abandoned

Date

FEB 5 1947

19

S. J. LEWIS

Scout

Kan

KANSAS Boggs Pool

Map No. K61 Sec. 17 Twp. 33 R. 12WWell No. 2 Boggs "C"Skelly CompanyCOMPLETE

Contractor

SE/C

E1. 1528

SECTION PLAT

 Ft. from N. Line330 Ft. from S. Line330 Ft. from E. Line Ft. from W. LineBarber CountyLocation Rig up

Drilling and Remarks:

Core 4881510 4831Bonnet RT251840 3/4

RECORD

Cased in., ft.Sand Gas Oil Total Depth 4881

PRODUCTION

1st 24 hrs. Nat. 1st 24 hrs. after shot Gas Cu. Ft.Dry Hole Abandoned

Date

APR 9 1947 19S. J. LEWIS Scout