

Section 17 Township 33 Range 12W

Well No. 11 Boggs "C"

Company Skelly

**Boggs**

NORTH

*15*

WEST

EAST


0

SOUTH

**KANSAS**

Barber

Sec. 17 Twp. 33 R. 12W ✓

Well No. #11 Boggs "C" Farm  
Skelly Company


Boggs Pool

\_\_\_\_\_ Ft. from N. Line

990' Ft. from S. Line

\_\_\_\_\_ Ft. from E. Line

330' Ft. from W. Line

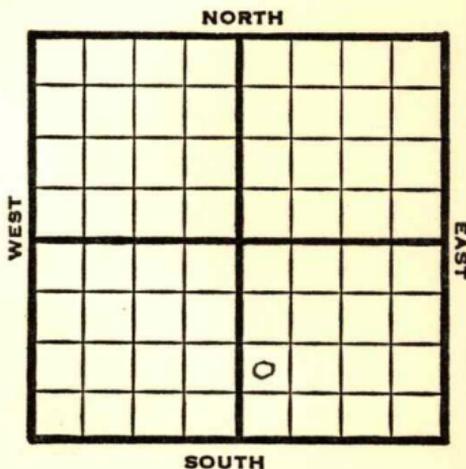

NW SW SE

1949

**Elev 1591'**

REPORT

6/22

RUR

6/28

8" @ 584'  
Drlg. 1360'

7/6

Drlg. 3377'

7/12

Drlg. 4398'

7/20

**Lans 3928'**  
**Miss 4501**  
**Viola 4792'**  
**Simp 4889'**

TD 4994'  
5" @ 4893'

7/27

"

8/3

"

8/10

"

8/17

"

8/24

TD 4994'  
**Simp 4889'**  
5" @ 4893'  
Pump 259 oil Pot  
43° Gr.  
Comp

**COMPLETED**

Kansas

Map No. \_\_\_\_\_ Sec. 17 Twp. 33 R. 12W

Well No. 11 Boggs "C"

Skelly \_\_\_\_\_ Company

\_\_\_\_\_ Contractor

NW SW SE

FIRST SECTION PLAT

\_\_\_\_\_ Ft. from N. Line

990 Ft. from S. Line

\_\_\_\_\_ Ft. from E. Line

330 Ft. from W. Line

		o	

Barber County

Location \_\_\_\_\_

Rig up \_\_\_\_\_

Drilling and Remarks:

R U R

RECORD

Cased \_\_\_\_\_ in., \_\_\_\_\_ ft.

Sand \_\_\_\_\_

Gas \_\_\_\_\_

Oil \_\_\_\_\_

Total Depth \_\_\_\_\_

PRODUCTION

1st 24 hrs. Nat. \_\_\_\_\_

1st 24 hrs. after shot \_\_\_\_\_

Gas \_\_\_\_\_ Cu. Ft.

Dry Hole \_\_\_\_\_

Abandoned \_\_\_\_\_

Date

June 22, 1949

S. J. LEWIS Scout

Map No. 561 Sec. 17 Twp. 33 R. 12W

Well No. 11 Boggs "C"

Skelly Company

**COMPLETE**

Contractor

NW SW SE

*21,1591*

**SECTION PLAT**

		0	

\_\_\_\_\_ Ft. from N. Line

990 Ft. from S. Line

\_\_\_\_\_ Ft. from E. Line

330 Ft. from W. Line

Barber County

Location \_\_\_\_\_

Rig up \_\_\_\_\_

Drilling and Remarks:

*Simple 4899  
5' @ 4893*

*Prod 209 oil Prod*

*4328*

**RECORD**

Cased \_\_\_\_\_ in., \_\_\_\_\_ ft.

Sand \_\_\_\_\_

Gas \_\_\_\_\_

Oil \_\_\_\_\_

Total Depth 4894

**PRODUCTION**

1st 24 hrs. Nat. \_\_\_\_\_

1st 24 hrs. after shot \_\_\_\_\_

Gas \_\_\_\_\_ Cu. Ft.

Dry Hole \_\_\_\_\_

Abandoned \_\_\_\_\_

Date

AUG 24 1949 19

S. J. LEWIS

Scout