


Section 17 Township 33 Range 12W

Well No. 14 Boggs "C"

Company Skelly Oil

76

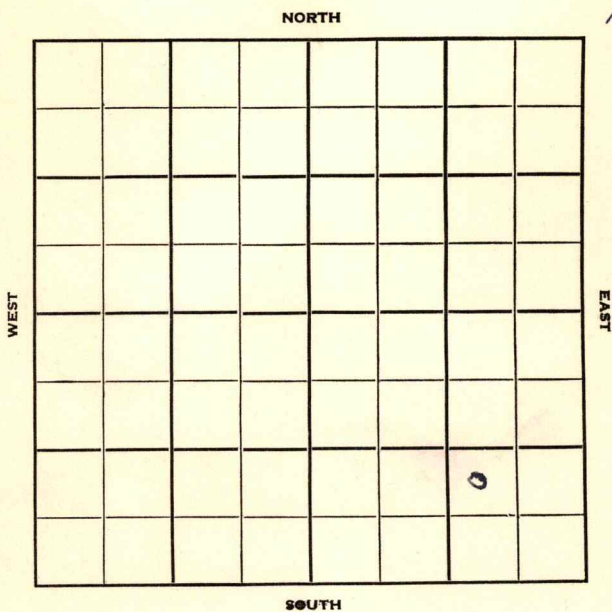

Barber

Sec. 17 Twp. 33 R. 12W ✓

Well No. #14 Boggs "C" Farm _____

Skelly Oil Company _____

Boggs Pool Contractor _____


_____ Ft. from N. Line

990' Ft. from S. Line

990' Ft. from E. Line

_____ Ft. from W. Line

NW SE SE

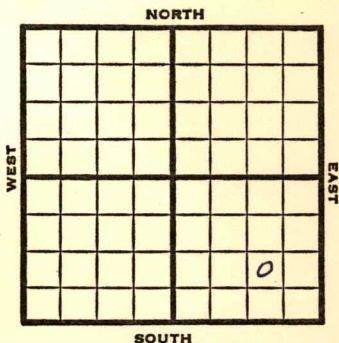

1951 **Elev. 1575'** REPORT

7/25 Location

10/24 Spud 7-28-51
 Oil well TD 4930' 8" @ 600
 Elgin sd. 3625' Doug. 3870'
 KC 3912' Miss 4490' Kh. 4659'
 Misener 4766-71' Viola 4471'
 Simp. sh. 4868' Simp. sd. 4873'
 TD 4930' 5" @ 4875' S/126 BO
 24 hr. 92 qt/4885-4930'
 S/75 BO 68 BW 6 hr. S/77 BO 10 BW
 7 hr. S/122 BOPD
 Comp. 329 BOPD

COMPLETED

