


Section 17 Township 33 Range 12W

Well No. #15 Boggs "C"

Company Skelly Oil

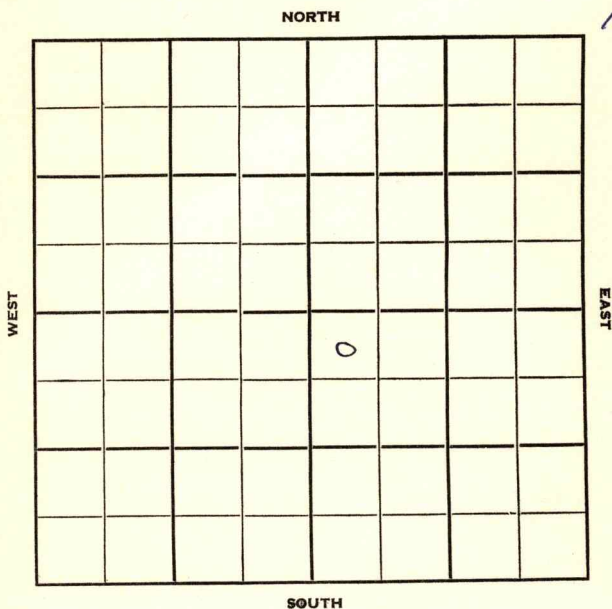

Barber

KANSAS

Sec. 17 Twp. 33 R. 12 W ✓

Well No. # 15 Boggs "C" Farm

Skelly Oil Company

Contractor

Boggs Pool


330 Ft. from N. Line

Ft. from S. Line

Ft. from E. Line

330 Ft. from W. Line

NW NW SE

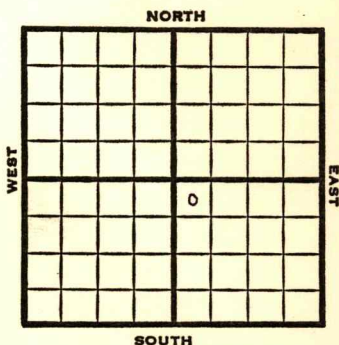

1951

Elev. 1534 REPORT

8/29
10/31

Location

Spud 8-31-51

Oil Well TD 4888

8" @ 597

Elgin sand 3590

Lans. 3881

Miss lime 4437

Kh 4626

Viola 4736

Simp Sh 4825

Simp Sd 4828

5" @ 4830 TD 4888

S/600 bopd Comp. 756 bopd

COMPLETED

County **Barber** State **Kansas**Sec. **17** (Blk. Twp.) **33** (Sur. Rge.) **12W** Map No.Operator **Skelly Oil**Well No. **15** Farm **Boggs "C"**Elev. Location **NW NW SE**

FIRST REPORT

330 Ft. From **N** Line **SE****330** Ft. From **W** Line Quarter1st. Report **AUG 9 9 1951**

Completion

Remarks

Spudding Date

Drlg. Data **Boggs Pool****Location**

J. E. TYRA

