


Section 17 Township 33 Range 12W

Well No. 17 Boggs "C"

Company Skelly Oil

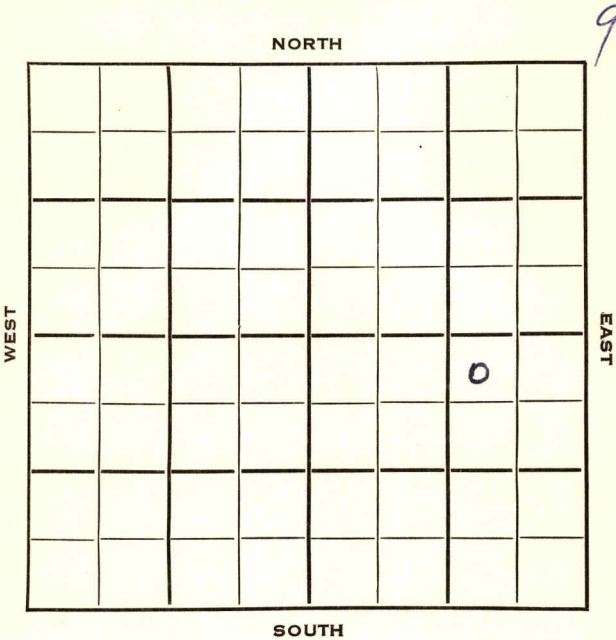

Barber **KANSAS**

SEC.	TWP.	R.
17	33	12 W ✓

WELL NO. # 17 Boggs "C"

COMPANY FARM

CONTRACTOR Skelly Oil

330 _____ Ft. from N. Line _____ Ft. from S. Line 990 _____ Ft. from E. Line _____ Ft. from W. Line	NORTH EAST <table border="1" style="margin: auto; border-collapse: collapse;"> <tr><td></td><td></td><td></td><td></td><td></td><td></td></tr> <tr><td></td><td></td><td></td><td></td><td></td><td></td></tr> <tr><td></td><td></td><td></td><td></td><td></td><td></td></tr> <tr><td></td><td></td><td></td><td></td><td>0</td><td></td></tr> <tr><td></td><td></td><td></td><td></td><td></td><td></td></tr> <tr><td></td><td></td><td></td><td></td><td></td><td></td></tr> <tr><td></td><td></td><td></td><td></td><td></td><td></td></tr> </table> WEST SOUTH																							0																			
				0																																							

NW NE SE

1954	ELEVATION 1531'	REPORT
3/31		Cellar & Pits
4/7		8" @ 544' w/300 sks Drlg 2540'
5/12		Spud 3-30-54 Oil Well TD 4871' 8" @ 544' Elgin sd 3570', Heeb 3713', Doug 3747' Tonganoxie Sd. 3849', Lans 3869' B KC 4353', Marm 4369', Kh. 4615' Chat 4681', Viola 4724', Simp 4814' DST 4845'-71' opn 1 hr, rec 1230' oil 180' mco, 1104# 5" @ 4870' CO to 4868' 59/ 4844-54 S/ 50 bo 15 hr. 17/ 4841'-44' S/ 60 bo 15 hr. sd-oil-frac. F/ 240 bo 8 hr. Comp 271 bopd.

COMPLETED

County Barber State Kansas
 Sec. 17 (Blk.) 33 (Sur.) 12W Map No.
 Operator Skelly Oil
 Well No. 17 Farm Boggs "C"
 Elev. _____ Location NW NE SE

FIRST REPORT

330 Ft. From N Line SE
990 Ft. From E Line Quarter

1st. Report MAR 31 1954

Completion _____

Remarks _____

Spudding Date _____

Drlg. Data _____

Cellar & pits

J. G. McGEHEE

County Barber State KansasSec. 17 (Blk. Twp.) 33 (Sur. Rge.) 12W Map No. _____Operator Skelly OilWell No. 17 Farm Boggs "C"Elev. 1531 Location NW NE SE330 Ft. From N Line SE990 Ft. From E Line Quarter1st. ReportCompletion MAY 12 1954RemarksSpudding Date 3-30-54Drlg. Data Oil well TD 48718" @ 544 Elgin sd. 3570 Heeb. 3713Doug. 3747 Tonganoxie sd. 3849Lans. 3869 B KC 4353 Marm. 4369Kh. 4615 Chat 4681 Viola 4724Simp. 4814 DST 4845-71 open 1 hr.Rec. 1230' oil 180' mco 1104#5" @ 4870 CO to 4868 59/ 4844-54S/ 50 bo 15 hr. 17/ 4841-44 S/ 60 bo15 hr. sd-oil-frac F/ 240 bo 8 hr.Comp. 271 bopd

J. G. McGEHEE