

Section 17 Township 33 Range 12W

Well No. #18 Boss "C"


Company Skelly Oil

NORTH

8

WEST

EAST

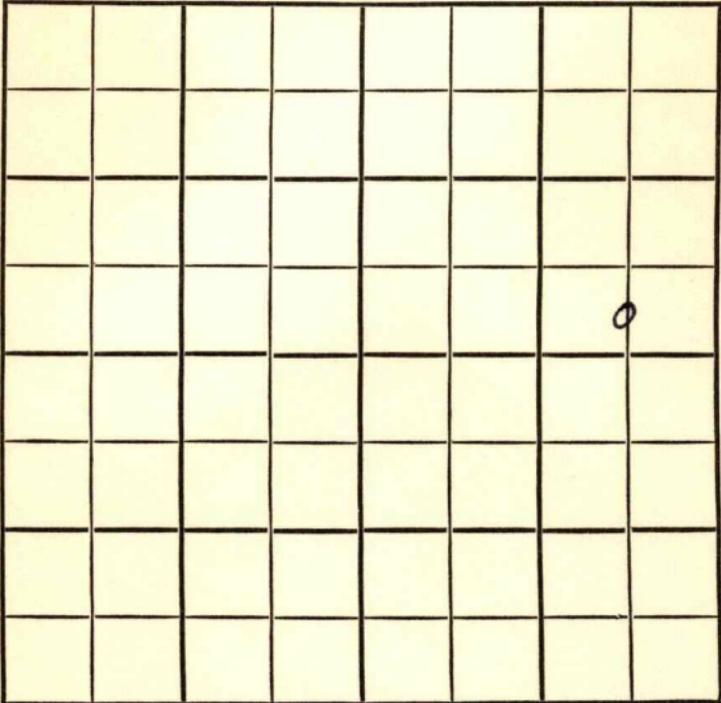

SOUTH

Barber

KANSAS

SEC.	TWP.	R.
17	33	12 W

WELL NO.

# 18 Boggs "C"

FARM

COMPANY

Skelly Oil

CONTRACTOR

Hulme Drlg.


Boggs Pool

Ft. from N. Line

330 Ft. from S. Line

660 Ft. from E. Line

Ft. from W. Line

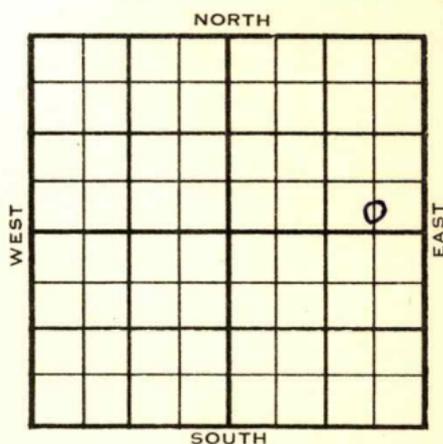C S $\frac{1}{2}$  SE NE

	ELEVATION	REPORT
1954	1488'	

8/18

Spud 8-14-54

8" @ 473

9/29

Spud 8-14-54 Oil well TD 4846

8" @ 473 Elgin 3548 Heeb 3664

Tong 3798' Lans 3830 Marm 4314

Miss 4386 Kh. 4567 Chattanooga

4616 Misener 4675 Viola 4679

Simp sh. 4772 Simp sd 4800 TD 4846

5" @ 4845 CO to 4830 96/4799-4815

S/105 BO 4 hrs. sd-oil frac. S/127

BO 2 BW 24 hrs. Comp. 308 BOPD

2% wtr.

**COMPLETED**

County **Barber** State **Kansas**

Sec. **17** (Blk.) **33** (Sur.) **12W** Map No. (Twp.)

Operator **Skelly Oil**

Well No. **18** Farm **Boggs "C"**

Elev. Location **C S  $\frac{1}{2}$  SE NE**


FIRST REPORT

**330** Ft. From **S** Line **NE**

**660** Ft. From **E** Line Quarter

Ist. Report **AUG 18 1954**

Completion

Remarks

**Hulme Drlg. - Contr.**

Spudding Date **8-14-54**

Drlg. Data **Boggs Pool**

**8" @ 473**

FABEN GILSTRAP

County Barber State Kansas

Sec. 17 (Blk. 33 (Sur. 12W Map No. (Twp.) Rge.)

Operator Skelly Oil

Well No. 18 Farm Boggs "C"

Elev. 1488 Location C S  $\frac{1}{2}$  SE NE



330 Ft. From S Line NE

660 Ft. From E Line Quarter

1st. Report Aug 18 1954

Completion SEP 29 1954

Remarks

Hulme Drlg. - Contr.

Spudding Date 8-14-54

Drlg. Data Oil well TD 4846 Boggs Pool

8" @ 473 Elgin 3548 Heeb. 3664

Tong. 3798 Lans. 3830 Marm. 4314

Miss. 4386 Kh. 4567 Chattanooga 4616

Misener 4675 Viola 4679 Simp. sh. 4772

Simp. sd. 4800 TD 4846 5" @ 4845

CO to 4830 96/ 4799-4815 S/ 105 bo 4 hr

sd-oil-frac S/ 127 bo 2 bw 24 hr.

Comp. 308 bopd 2% wtr.

FABEN GILSTRAP