

Barber

DX 78-1

KANSAS

Section 17 Township 33 Range 12W


Well No. #19 Boggs "C"

Company Skelly Oil

NORTH

WEST

EAST

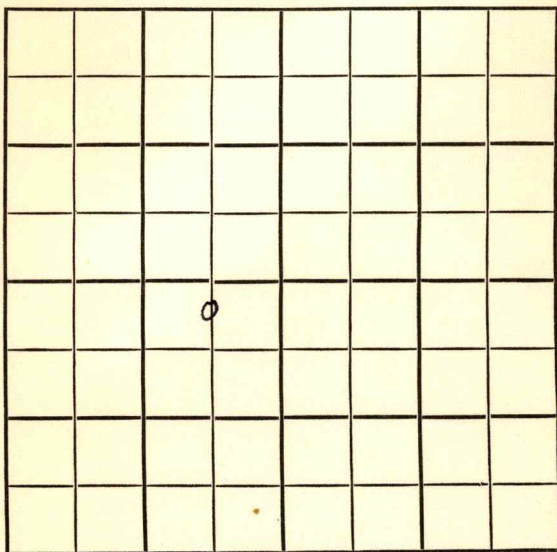

SOUTH

Barber

KANSAS

|      |      |      |
|------|------|------|
| SEC. | TWP. | R.   |
| 17   | 33   | 12 W |

WELL NO.

# 19 Boggs "C"

FARM

COMPANY

Skelly Oil

CONTRACTOR

Wentworth

Boggs Pool

330


Ft. from N. Line

Ft. from S. Line

660

Ft. from E. Line

Ft. from W. Line

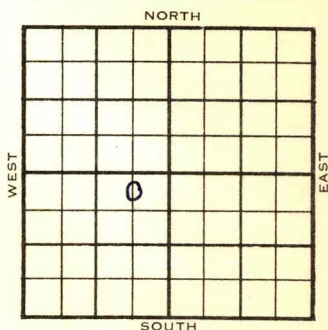C N $\frac{1}{2}$  NE SW

1954

ELEVATION

1529'

REPORT

8/18

Spud 8-15-54

Drlg. 400'

11/3

Spud 8-15-54 - Gas Well

TD 4917'

8" @ 475'

Elgin sd 3602', Heeb 3715', Tong 3846',

Lans 3873', Miss 4422'

DST 4420-72', opn 1 hr., rec. 65' mud, 610#

Kh. 4613', Chattanooga 4671', Misener

4722', Viola 4726', Simp. sh 4823',

Simp. sd 4847'

DST 4825-97', opn 1 hr., rec. 90' hocr, 180' mud &amp; gco, 780' sw, 1555#

TD 4917'

5" @ 4916'

CO to 4912'

23/4864-68, B/6 bwph

CO to 4863, 24/4850-54, S/8 bo 2 bw

4 hrs., 18/4847-50, S/13 bo 1/2 bw 12 hrs.

Sd-oil-frac, PB 4855

S/60 bw 18 hrs., PB 4840'

24/4836-40, sd-oil-frac

S/88 bw 14 hrs.

CO to 4855

24/4847-51 300 gw 15 hrs., 250A

OVER

(Information Brought Forward)

1954  
11/3

S/2 bo 53 bw 15 hrs.,

PB 4610'

138/4425-38, 500A

100,000 cfg

Sd-oil-frac, 500,000 cfg

1000A

140,000 cfg, 500A

196,000 cfg

Sd-oil-frac, 1,010,000 cfg, 1075#

F/1,912,000 cfg

omp. 2,071,000 cfgpd

**COMPLETED**

County **Barber** State **Kansas**

Sec. **17** (Blk. **33** (Sur. **12W** Map No.

Operator Skelly Oil

Well No. **19** Farm **Boggs "C"**

|       |          |                         |
|-------|----------|-------------------------|
| Elev. | Location | C N $\frac{1}{2}$ NE SW |
|-------|----------|-------------------------|

0

FIRST REPORT

330 Ft. From N Line SW

660 Ft. From E Line Quarter

1st. Report      AUG 18 1954

### Completion

Remarks

Wentworth - Contr.


Spudding Date 8-15-54

Drig. Data Boggs Pool

drlg. 400

FABEN GILSTRAP

County Barber State Kansas  
 Sec. 17 (Blk.) 33 (Sur.) 12W Map No.  
 Operator Skelly Oil  
 Well No. 19 Farm Boggs "C"  
 Elev. 1529 Location C N $\frac{1}{2}$  NE SW

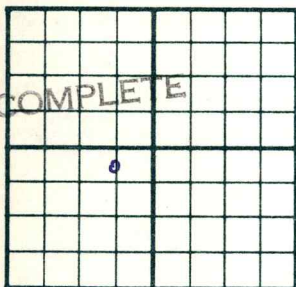

330 Ft. From N Line SW  
660 Ft. From E Line Quarter  
 1st. Report  
 Completion NOV 3 1954  
 Remarks Boggs Pool  
Wentworth - Contr.  
 Spudding Date 8-15-54

Drlg. Data Gas well TD 4917  
8" @ 475 Elgin sd. 3602 Heeb. 3715  
Tong. 3846 Lans. 3873 Miss. 4422  
DST 4420-72 open 1 hr. Rec. 65' mud  
610# Kh. 4613 Chattanooga 4671  
Misener 4722 Viola 4726 Simp. sh. 4823  
Simp. sd. 4847 DST 4825-97 open 1 hr.  
Rec. 90' hocr 180' mud & gco 780' sw  
1555# TD 4917 5" @ 4916 CO to 4912  
23/ 4864-68 B/ 6 bwph CO to 4863  
24/ 4850-54 S/ 8 bo 2 bw 4 hr.  
18/ 4847-50 S/ 13 bo  $\frac{1}{2}$  bw 12 hr.  
sd-oil-frac PB 4855 S/ 60 bw 18 hr.  
PB 4840 24/ 4836-40 sd-oil-frac  
S/ 88 bw 14 hr. CO to 4855 24/ 4847-51

FABEN GILSTRAP

Drlg. Data

300 gw 15 hr. 250 A S/ 2 bo 53 bw


15 hr. PB 4610 138/ 4425-38 500 A

100,000 cfg ~~sd-oil-frac~~ 500,000 cfg

1000 A 140,000 cfg ~~500 A~~ 196,000 cfg

sd-oil-frac 1,010,000 cfg 1075#

F/ 1,912,000 cfg Comp. 2,071,000 cfgpd

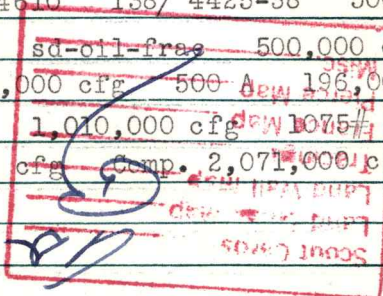

NOV 10 1954