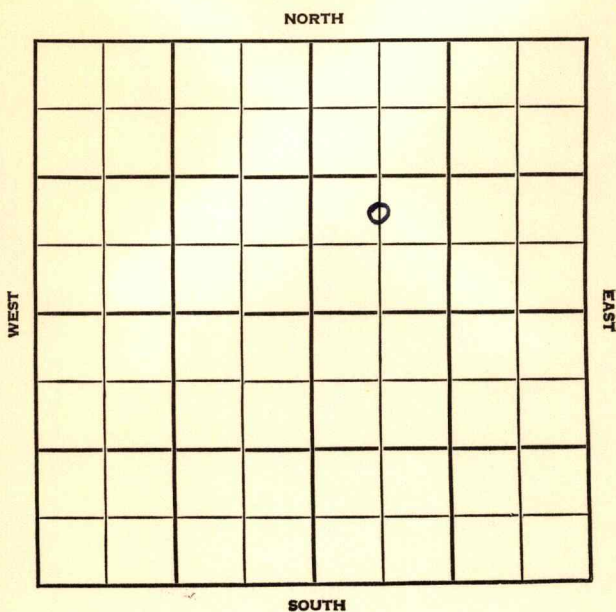


Section 17 Township 33 Range 12WWell No. 20 Boggs "C"Company Skelly Oil

SEC.	TWP.	R.
17	33	12W
WELL NO.		
#20 Boggs "C"		
COMPANY		FARM
Skelly Oil		
CONTRACTOR		

Boggs Pool

Ft. from N. Line


990

Ft. from S. Line

Ft. from E. Line

660

Ft. from W. Line

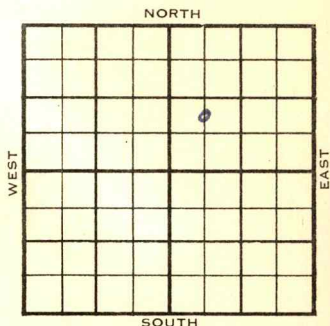C N $\frac{1}{2}$ SW NE

1955

ELEVATION

1524'

REPORT

1/19

Location

3/16

Spud 1-21-55, Oil Well, TD 4868
 8" @ 610, Heeb 3697, Tong 3824,
 Br Lime 3850, Lans 3860, B KC
 4335, Marm 4348, Miss 4428,
 KH 4599, Viola 4704, Simp Sh
 4791, Simp dolo. 4799, Simp Sd
 4813,
 DST 4813-68, open 1 hr gas in
 2 min, Rec 396,000 cfg 180'
 Oil 360' SGCMO, 180' HO&GCM
 120' GCWM 900# TD 4868 5" @
 4868 CO to 4865, 36/4841-47,
 2 GOPH 16 hr Viso-frac PB 4833
 42/4824-31, S/343 14 BW 24 hr
 P/98 bo
 Comp. 167 BOPD $\frac{5}{8}$ 4% Wtr.

COMPLETED

County **Barber** State **Kansas**

Sec. **17** (Blk. **33** (Sur. **12W** Map No.

Operator Skelly Oil

Well No. 20 Farm Boggs "C"

Elev.	Location	C N $\frac{1}{2}$ SW NE
-------	----------	-------------------------


990 Ft. From S Line NE

660 Ft. From W Line Quarter

JAN 19 1955

1st. Report

Completion

Remarks

Spudding Date _____

Drlg. Data Boggs Pool

Location

FABEN GILSTRAP

County Barber State Kansas
 Sec. 17 (Blk. Twp.) 33 (Sur. Rge.) 12W Map No. _____
 Operator Skelly Oil
 Well No. 20 Farm Boggs "C"
 Elev. 1524 Location C N $\frac{1}{2}$ SW NE



990 Ft. From S Line NE

660 Ft. From W Line Quarter

1st. Report

Completion MAR 16 1955

Remarks Boggs Pool

Spudding Date 1-21-55

Drlg. Data Oil well TD 4868

8" @ 610 Heeb. 3697 Tong. 3824

Br. lime 3850 Lans. 3860 B KC 4335

Marm. 4348 Miss. 4428 Kh. 4599

Viola 4704 Simp. sh. 4791 Simp. dolo.

4799 Simp. sd. 4813 DST 4813-68

open 1 hr. gas in 2 min. Rec. 396,000

crg 180' oil 360' sgcmo 180' ho & gcm

120' gcwm 900# TD 4868 5" @ 4868

CO to 4865 36/ 4841-47 2 goph 16 hr.

viso-frac PB 4833 42/ 4824-31

S/ 343 bo 14 bw 24 hr. P/ 98 bo

Comp. 167 bopd 4% wtr.

FABEN GILSTRAP