


Section 17 Township 33 Range 12 W

Well No. # 21 Boggs "C"

Company Skelly Oil

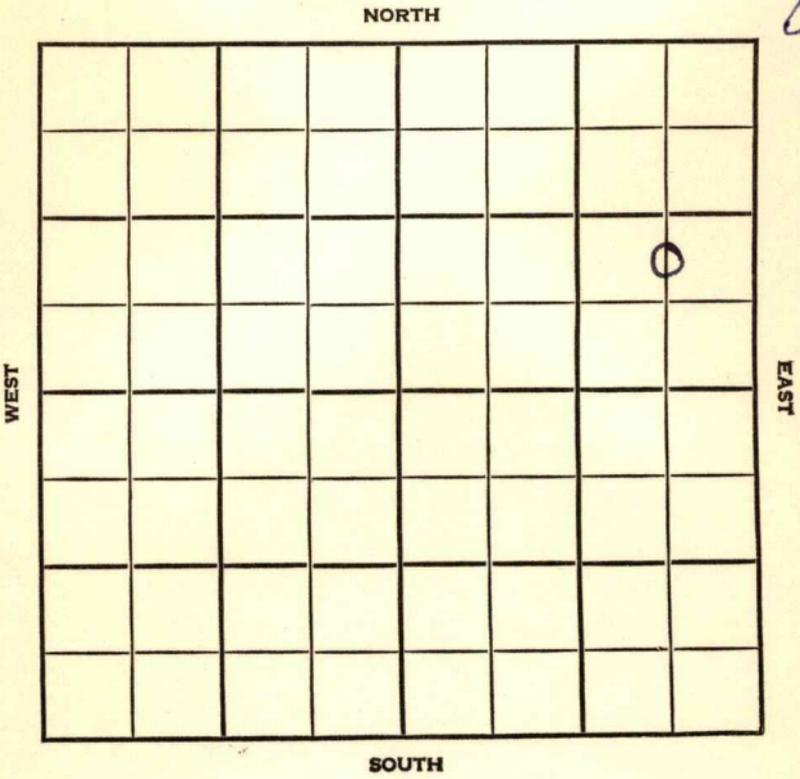

SEC.	TWP.	R.
17	33	12W

WELL NO.

#21 Boggs "C"

FARM

COMPANY

Skelly Oil

CONTRACTOR

Hulme


Boggs Pool

\_\_\_\_\_ Ft. from N. Line

990 \_\_\_\_\_ Ft. from S. Line

660 \_\_\_\_\_ Ft. from E. Line

\_\_\_\_\_ Ft. from W. Line

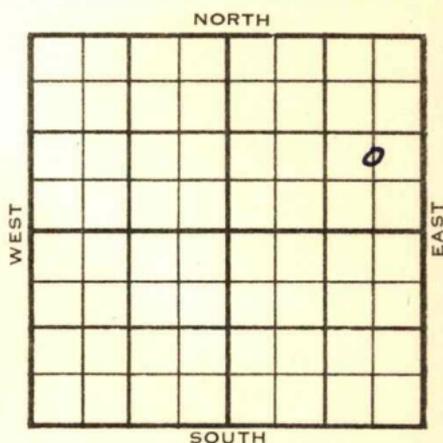C N  $\frac{1}{2}$  SE NE

1955	ELEVATION 1482'	REPORT
------	--------------------	--------

2/9	Location
4/20	<p>Spud 2-15-55 Oil well TD 4859  8" @ 325 Heeb 3664 Br line 3818  Lans 3830 B KC 4307' Marm 4318'  Miss 4394 Kh. 4562' Viola 4672'  Simp. sh. 4772 Simp. sd. 4789'  TD 4859' 5" @ 4859 60/4789-99  S/28 BO 15 hr. sd-oil-frac. S/95 BO  54 BW 13 hr. Comp. 211 BOPD 4%wtr.</p>

**COMPLETED**



