


DX 78-1

Section 18 Township 33 Range 12W

Well No. 1 E. F. Bartholow

Company Skelly Oil

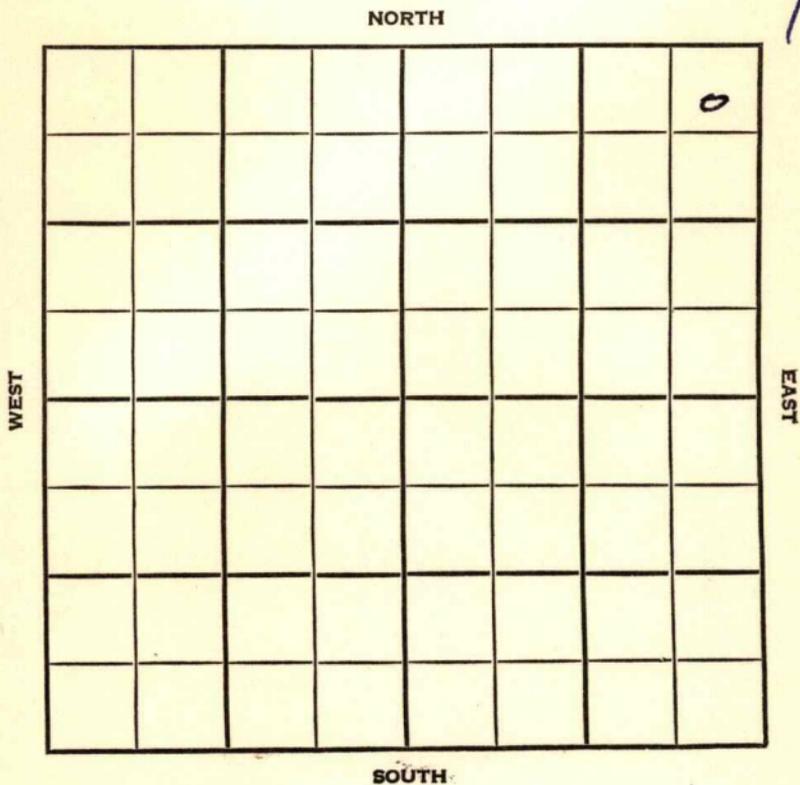


SEC.	TWP.	R.
18	33	12W

WELL NO. _____
 COMPANY **1 E. F. Bartholow** FARM

CONTRACTOR **Skelly Oil**

330 Ft. from N. Line
 _____ Ft. from S. Line
 330 Ft. from E. Line
 _____ Ft. from W. Line

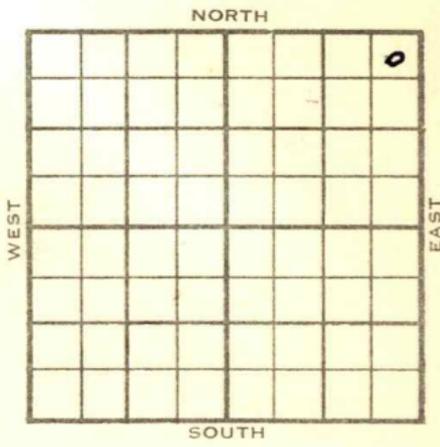

NE NE NE

	ELEVATION	REPORT
1954	1580'	

6/9 Loc.
 6/23 8" @ 476 w/300
 Drlg. 3350'
 7/28 Spud 6-12-54 - Gas Well
 TD 5051'
 8" @ 476'
 Elgin 3621', Heeb 3752', Doug 3790',
 Lans 3914', B KC 4388', Marm 4395',
 Miss 4463'
 DST 4456-77', opnl 1/2 hrs., rec. 1/2 mcfg
 65' sgc, 1580#
 Kh. 4653', Chat 4737', Meisner 4781',
 Viola 4788', Simp. 4889', Simp sh
 4888, Simp. sd 4912', Arb. 4991'
 TD 5051'
 5 1/2" @ 4948'
 CO to 4914, 54/4900-09, 17 gswph, 14 hr
 250A, 250A, S/2 bwph 5 hrs.
 PB 4495 112/4457-76, sd-oil-frac
 648,000 gas, sd-oil-frac
 Comp. 7,120,000 cfpd

COMPLETED

County **Barber** State **Kansas**

Sec. **18** (Blk.) **33** (Sur.) **12W** Map No.

Operator **Skelly Oil**

Well No. **1** Farm **E. F. Bartholow**

Elev. Location **NE NE NE**

330 Ft. From **N** Line **NE**

330 Ft. From **E** Line Quarter

1st. Report **JUN 9 1954**

Completion

Remarks

Spudding Date

Drlg. Data

Location

County Barber State KansasSec. 18 (Blk. Twp.) 33 (Sur. Rge.) 12W Map No.Operator Skelly OilWell No. 1 Farm E. F. BartholowElev. 1580 Location NE NE NE

330 Ft. From N Line NE330 Ft. From E Line Quarter

1st. Report

Completion JUL 28 1954

Remarks

Spudding Date 6-12-54Drlg. Data Gas well TD 50518" @ 476 Elgin 3621 Heeb. 3752Doug. 3790 Lans. 3914 B KC 4388Marm. 4395 Miss. 4463 DST 4456-77open 1½ hr. Rec. ½ mcfg 65' sgcm1580# Kh. 4653 Chat 4737 Meisner 4781Viola 4788 Simp. 4889 Simp. sh. 4888Simp. sd. 4912 Arb. 4991 TD 50515½" @ 4948 CO to 4914 54/ 4900-0917 gswph 14 hr. 250 A 250 AS/ 2 bwph 5 hr. PB 4495 112/ 4457-76sd-oil-frac 648,000 gas sd-oil-fracComp. 7,120,000 cfgpd