



Barber county

Section 20 Township ~~33~~ 34 Range 12-W

Well No. #1, Smith "A"

Company Continental Oil Co.

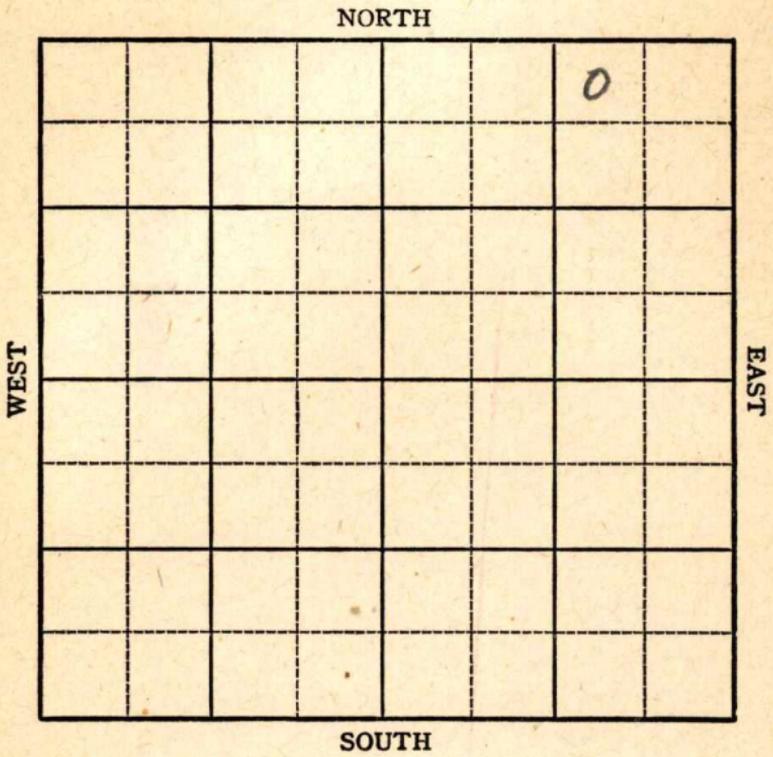

Sec. 20 Twp. 33 R. 12W

Well No. 1 Smith "A" Farm _____
Continental Company _____


Boggs Pool

330 Ft. from N. Line

_____ Ft. from S. Line

990 Ft. from E. Line

_____ Ft. from W. Line

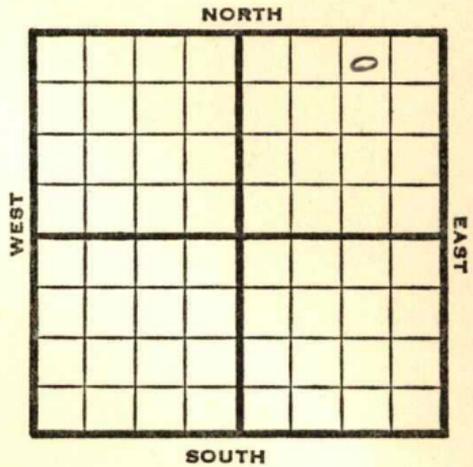

NW NE NE

1947 **1570** REPORT

- 1/8 Location
- 1/15 "
- 1/21 13" @ 278
WOC
- 1/30 9" @ 1316'
WOC
- 2/12 Drlg 3946'
- 2/19 Drlg 4730'
- 2/26 **Miss 4569'**
Viola 4773
Simp Sand 4778
Drlg 4996'
- 3/4 **Arb 5016'-68**
TD 5068'
RUST
- 3/11 TD 5068'

(over)

3/26

Simp. 4778'

Arb. 5016'

6" @ 4988'

Perf. Simp.

Floco 770 Pot.

39.0 Gr.

TD 5068'.

COMPLETED

Map No. 61 Sec. 20 Twp. 33 R. 12W

Well No. 1 Smith "A"

Continental Company

FIRST REPORT

Contractor

NW NE NE


SECTION PLAT

330 Ft. from N. Line

_____ Ft. from S. Line

990 Ft. from E. Line

_____ Ft. from W. Line

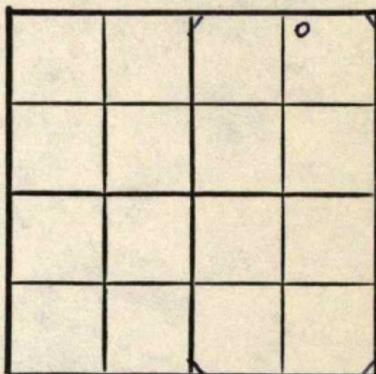

Barber County

Location X

Rig up _____

Drilling and Remarks: _____

RECORD

Cased _____ in., _____ ft.

Sand _____

Gas _____

Oil _____

Total Depth _____

PRODUCTION

1st 24 hrs. Nat. _____

1st 24 hrs. after shot _____

Gas _____ Cu. Ft.

Dry Hole _____

Abandoned _____

Date

JAN 8 1947 19 _____

S. J. LEWIS Scout

