


Section 20 Township 33 Range 12W

Well No. 4 McCullough

Company Continental

Boggs  
NORTH

3

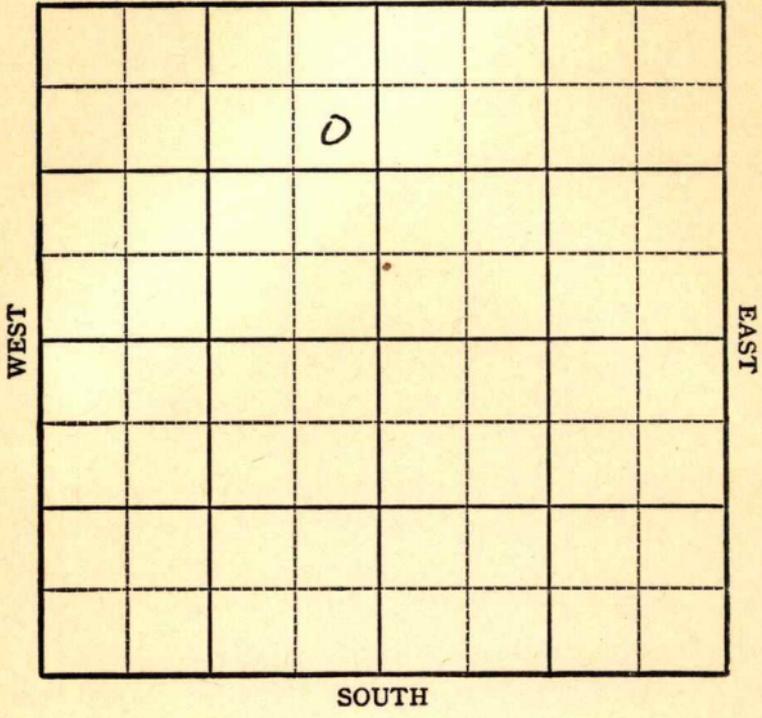

Sec. 20 Twp. 33 R. 12-W ✓

Well No. #4 McCullough Farm  
Continental<sup>1</sup> Company  
Boggs

990 Ft. from N. Line


\_\_\_\_\_ Ft. from S. Line

330 Ft. from E. Line

330 Ft. from W. Line

SE NE NW

~~SW NW NW~~

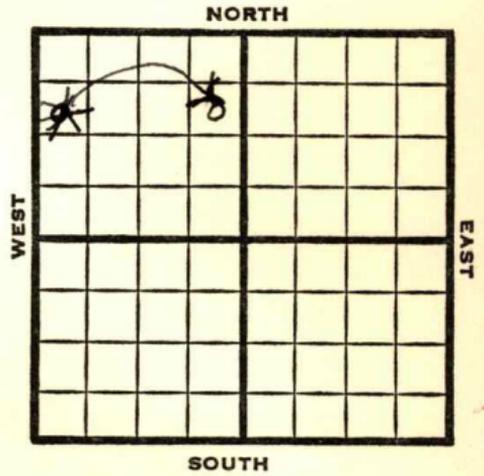

1949	Elev 1592'	REPORT
1/26	Location	
2/2	"	
2/9	"	
2/16	13" @ 222'	
	Drlg. 640'	
2/23	Drlg. 1870'	
3/2	TD 3965'	
3/8	Drlg 4780'	
3/16	Lansing 3950'	Miss 4529'
	Viola 4802'	Simpson 4901'
	TD 4950'	
	7" @ 4910'	
3/23	4000' oil	
3/30	"	
4/6	20 qts 4927-37 CO	
4/12	Swb 199 bbls oil - 5 hrs.	
4/20	"	
4/27	Flow 62 bbls oil 2 hrs.	
	1" @ hole	
	Gr. 28.8°	
5/4	TD 4947'	
	Simp 4901'	
	7" @ 4910'	
	20 qts 4927-37	
	Pump 69 Oil Pot	
	28 <sup>8</sup> Gr.	
	Comp	

COMPLETED

Kansas

Map No. \_\_\_\_\_ Sec. 20 Twp. 33 R. 12W

Well No. 4 McCullough

Continental Company

CORRECTION

Contractor

SE NE NW

SECTION PLAT

990 Ft. from N. Line

\_\_\_\_\_ Ft. from S. Line

330 Ft. from E. Line

\_\_\_\_\_ Ft. from W. Line

		o	

Barber County

Location \_\_\_\_\_

Rig up \_\_\_\_\_

Drilling and Remarks:

Reported

SW NW NW

RECORD

Cased \_\_\_\_\_ in., \_\_\_\_\_ ft.

Sand \_\_\_\_\_

Gas \_\_\_\_\_

Oil \_\_\_\_\_

Total Depth \_\_\_\_\_

PRODUCTION

1st 24 hrs. Nat. \_\_\_\_\_

1st 24 hrs. after shot \_\_\_\_\_

Gas \_\_\_\_\_ Cu. Ft.

Dry Hole \_\_\_\_\_

Abandoned \_\_\_\_\_

Date

JAN 26 1949

19

S. J. LEWIS

Scout

Kansas

Map No. \_\_\_\_\_ Sec. 20 Twp. 33 R. 12W

Well No. 4 McCullough

Continental Company

FIRST REPORT Contractor

SW NW NW

SECTION PLAT

990 Ft. from N. Line

\_\_\_\_\_ Ft. from S. Line

\_\_\_\_\_ Ft. from E. Line

330 Ft. from W. Line

o			

Barber County

Location X

Rig up

Drilling and Remarks:

RECORD

Cased \_\_\_\_\_ in., \_\_\_\_\_ ft.

Sand \_\_\_\_\_

Gas \_\_\_\_\_

Oil \_\_\_\_\_

Total Depth \_\_\_\_\_

PRODUCTION

1st 24 hrs. Nat. \_\_\_\_\_

1st 24 hrs. after shot \_\_\_\_\_

Gas \_\_\_\_\_ Cu. Ft.

Dry Hole \_\_\_\_\_

Abandoned \_\_\_\_\_

Date

JAN 26 1949 19

S. J. LEWIS Scout

Map No. K61 Sec. 20 Twp. 33 R. 12W

Well No. 4 McCullough

Continental Company

**COMPLETE**

Contractor

SE NE NW

*E. 1092*

**SECTION PLAT**

990 Ft. from N. Line

         Ft. from S. Line

330 Ft. from E. Line

         Ft. from W. Line

	o		

Barber County

Location                                 

Rig up                                 

Drilling and Remarks:

*Snap 4901*  
*7" C 4910*  
*209 to 4927-37*  
*Prod 69 oil 2X*  
*2558*

**RECORD**

Cased          in.,          ft.

Sand                                 

Gas                                 

Oil                                 

Total Depth 4947

**PRODUCTION**

1st 24 hrs. Nat.                         

1st 24 hrs. after shot                         

Gas                                  Cu. Ft.

Dry Hole                                 

Abandoned                                 

Date

MAY 4 1949 19

S. J. LEWIS

Scout