

Barber


KANSAS

FORM 51 IOM 12-46 PETROL

Section 20 Township 33 Range 12W

Well No. 4 Smith "A"

Company Continental

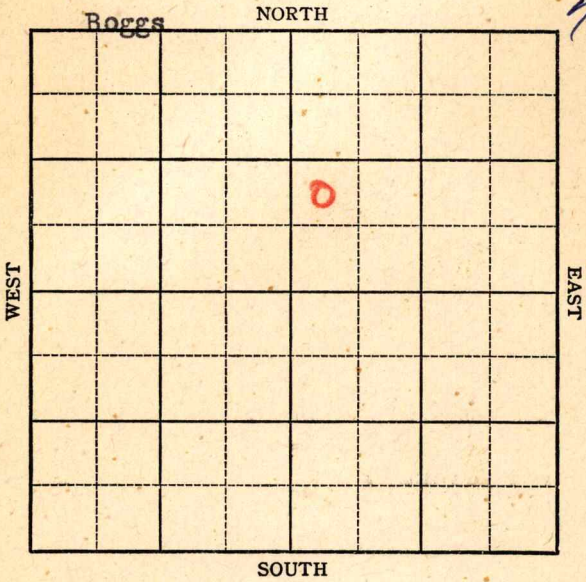

KANSAS

Barber County

Sec. 20 Twp. 33 R. 12-W

Well No. 4 Smith "A" Farm

Continental Company

Boggs Pool

Ft. from N. Line


990

Ft. from S. Line

Ft. from E. Line

330

Ft. from W. Line

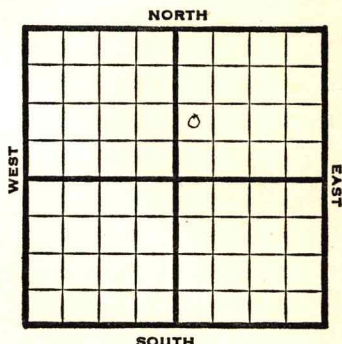

NW SW NE

1947	REPORT
	Elev. 1604'
7/30	Derrick
8/6	RUR
8/13	Drlg. 1735'
8/20	9" @ 1752' Drlg 3080'
8/27	Drlg. 4344'
9/3	Viola 4822' Drlg. 4925'
9/10	Mississippi 4549' Simpson 4925' TD 4979' 6" @ 4928' RUST
9/17	Flow 170 bbls. oil 9 hrs.
9/24	Simp. 4925' 6" @ 4928' Flow 461 Pot 41.0 Gr. TD 4979'
	COMPLETED

Map No. _____ Sec. 20 Twp. 33 R. 12W

Well No. 4 Smith "A"

Continental
FIRST REPORT

Company

Contractor

NW SW NE

SECTION PLAT

		6	

_____ Ft. from N. Line

990 Ft. from S. Line

_____ Ft. from E. Line

330 Ft. from W. Line

Barber County

Location _____

Rig up _____

Drilling and Remarks:

Derrick

RECORD

Cased _____ in., _____ ft.

Sand _____

Gas _____

Oil _____

Total Depth _____

PRODUCTION

1st 24 hrs. Nat. _____

1st 24 hrs. after shot _____

Gas _____ Cu. Ft.

Dry Hole _____

Abandoned _____

Date

JUL 30 1947

19

S. J. LEWIS

Scout

Map No. 61 Sec. 20 Twp. 33 R. 12W

Well No. 4 Smith "A"

Continental Company

COMPLETE

Contractor

NW SW NE

E1,1604
SECTION PLAT

		0	

 Ft. from N. Line

990 Ft. from S. Line

 Ft. from E. Line

330 Ft. from W. Line

Barber County

Location

Rig up

Drilling and Remarks:

*Sing 4925
6" @ 4928.*

Flow 461 Psd

41' 0" Cu

RECORD

Cased in., ft.

Sand

Gas

Oil

Total Depth 4928

PRODUCTION

1st 24 hrs. Nat.

1st 24 hrs. after shot

Gas Cu. Ft.

Dry Hole

Abandoned

Date

SEP 24 1947 19

S. J. LEWIS

Scout