


Section 21 Township 33 Range 12W

Well No. 2 Smith

Company Continental

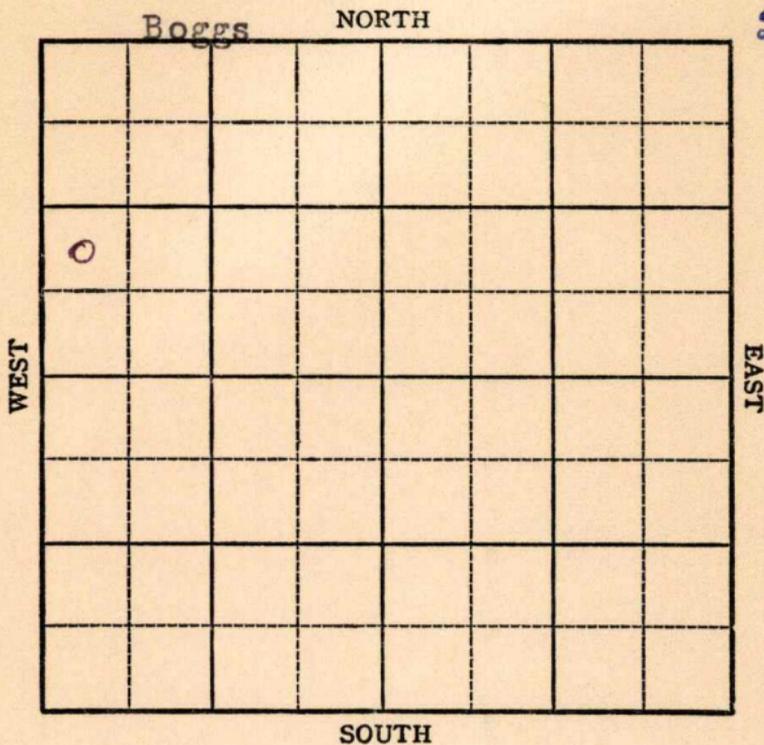

Sec. 21 Twp. 33 R. 12W

Well No. #2 Smith Farm

Continental Company

Boggs


Ft. from N. Line

990 Ft. from S. Line

Ft. from E. Line

330 Ft. from W. Line

NW SW NW

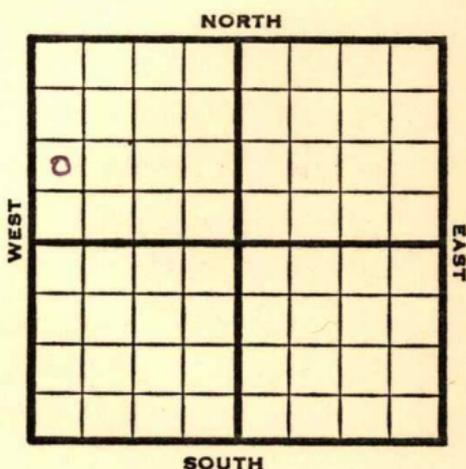

1947

Elev. 1585' REPORT

8/27 Location

9/3 "

9/10 Derrick

9/17 RUR

9/24 8" @ 1754'
WOC

10/1 Drlg. 4155'

10/8 **Viola 4795'**
Simpson 4894'
Drlg. 4904'

10/15 TD 4948'
6" @ 4913'
Flow 384 bbls oil in 8 hrs.

10/22 Fishing

10/29 **Simpson 4894'**
6" @ 4913'
Bom & Pot 2243
TD 4948'
Gravity 47

COMPLETED

Kallens

Map No. _____ Sec. 21 Twp. 33 R. 12WWell No. 2 Smith

_____ Continental _____ Company

_____ FIRST REPORT _____ Contractor

NW SW NW

SECTION PLAT

_____ Ft. from N. Line

990 Ft. from S. Line

_____ Ft. from E. Line

330 Ft. from W. Line

| | | | |
|---|--|--|--|
| | | | |
| o | | | |
| | | | |
| | | | |

Barber County

Location X

Rig up _____

Drilling and Remarks:

RECORD

Cased _____ in., _____ ft.

Sand _____

Gas _____

Oil _____

Total Depth _____

PRODUCTION

1st 24 hrs. Nat. _____

1st 24 hrs. after shot _____

Gas _____ Cu. Ft.

Dry Hole _____

Abandoned _____

Date

AUG 27 1947 19S. J. LEWIS

Scout

