


KANSAS

Barber county

Section 21 Township 33 Range 12-W

Well No. #1, Smith

Company Continental Oil Company

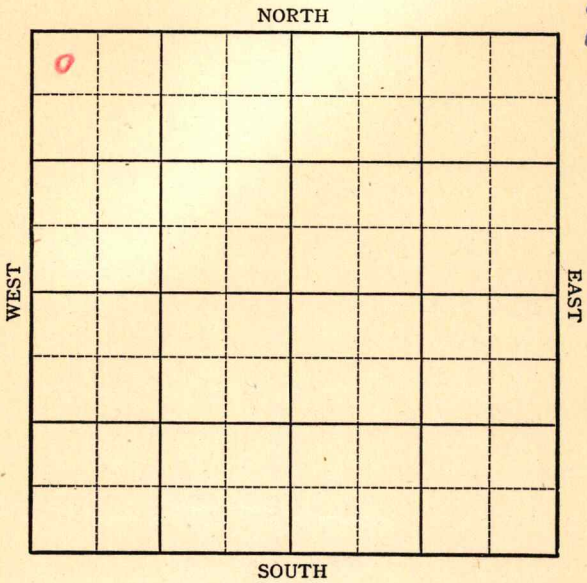

KANSAS

Barber ✓

Sec. 21 Twp. 33 R. 12W

Well No. #1 Smith Farm

Continental Company

Wildcat


330 Ft. from N. Line

 Ft. from S. Line

 Ft. from E. Line

330 Ft. from W. Line

NW/C

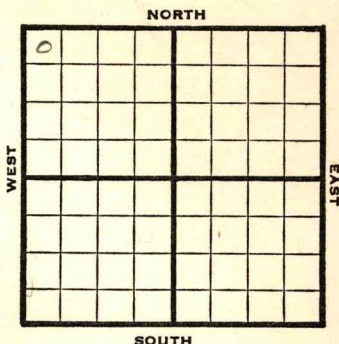

1946 **Elev. 1532'** REPORT E/v-1532

10/23	Derrick
10/29	13" @ 185 WOC
11/6	9" @ 1591' WOC
11/12	Drlg 3300'
11/20	Drlg 4080'
11/27	Lans 3872' Drlg 4675'
12/5	Miss. 4572' Meisner 4735' Viola 4738' Simpson shale 4843' Total Depth 4893' in sand DST 4860'-93' Open 20 minutes Gas in 18 minutes 4400' oil in 20 minutes 6" set 4857' Waiting on cement. (Tel)
12/10	Total Depth 4893' Drilled cement Cleaned out & flowed 70 bbls. 1st.hr. 80 bbls. 2nd.hr. Shut in Gravity 24.5 Will test (Tel)
12/17	Flow 1405 oil $\frac{1}{4}$ " choke 24 hrs

OVER

1947

1/2 **Simp Sand 4849'**
6" @ 4857'
TD 4893'
Flow 1405 POT
26.4 Grav.


COMPLETED

Kansas

Map No. C1 Sec. 21 Twp. 33 R. 12WWell No. 1 SmithContinental CompanyFIRST REPORT Contractor

NW/C

SECTION PLAT

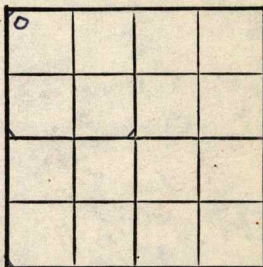330 Ft. from N. Line Ft. from S. Line Ft. from E. Line330 Ft. from W. LineBarber CountyLocation Rig up

Drilling and Remarks:

Derrick

RECORD

Cased in., ft.Sand Gas Oil Total Depth

PRODUCTION

1st 24 hrs. Nat. 1st 24 hrs. after shot Gas Cu. Ft.Dry Hole Abandoned

Date

19S. J. LEWIS Scout

KANSAS

Map No. 61 Sec. 21 Twp. 33 R. 12WWell No. 1 SmithContinental

Company

COMPLETED

Contractor

NW/C

F11534

SECTION PLAT

0			

330 Ft. from N. Line Ft. from S. Line Ft. from E. Line330 Ft. from W. Line

Barber County

Location

Rig up

Drilling and Remarks:

*Single Sol 4849**6" C 4857**Flow 1405 P.O.**26 4/82*

RECORD

Cased in., ft.Sand Gas Oil Total Depth 4893

PRODUCTION

1st 24 hrs. Nat. 1st 24 hrs. after shot Gas Cu. Ft.Dry Hole Abandoned

Date

JAN 2 1947 19

S. J. LEWIS

Scout