

Sec. 21 Twp. 33 R. 12W

Well No. #4 Smith Farm _____

Continental Company


Boggs Pool

_____ Ft. from N. Line

990' Ft. from S. Line

_____ Ft. from E. Line

330' Ft. from W. Line

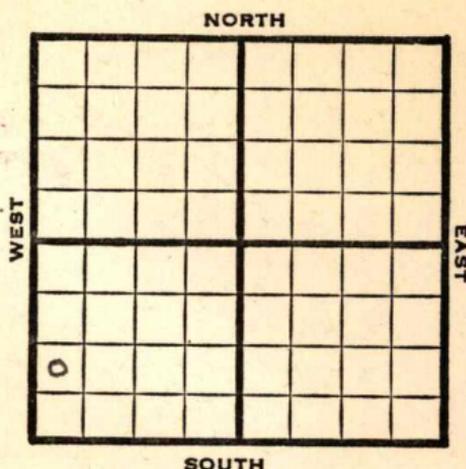

NW SW SW

1948 **Elev. 1621'** REPORT

- 2/4 Derrick
- 2/11 "
- 2/18 13" @ 197'
WOC
- 2/25 10" @ 1572'
Drlg. 1889'
- 3/3 Drlg. 3340'
- 3/10 Drlg. 4547'
- 3/17 Drlg. 4734'
- 3/24 **Viola 4863'**
Simpson Sd 4961'
TD 5021'
6" @ 4966'
RUST
- 3/31 "
- 4/7 Swb. 39 bbls. oil / 81 water 24 hrs.
- 4/14 "
- 4/21 "
- 4/28 **Simp 4961'**
6" @ 4966'
Pump 29 oil & 25 W Pot.
Gr. 420
TD 5021'

COMPLETED

OVER

1953

5/20

O. W. P. B.

Lans 3970' Miss 4588'

Viola 4863'

Simp. 4961' OTD 5021'

PB 4895'

CO to test Misener.

5/28

NR

7/1

NR

7/22

D&A

TD 5021

~~XXXXXXXXXX~~

Lans 3970, Miss 4588, Simp 4961

OTD 5021

PB 4895

Misner 4866, ^V iola 4871

24/4864-72, B/5 go 1½ bw 1 hr.

FUL200' sw & 6 go

D&A

ABANDONED

Map No. _____ Sec. 21 Twp. 33 R. 12W

Well No. 4 Smith

Continental Company

FIRST REPORT

Contractor

NW SW SW

SECTION PLAT

_____ Ft. from N. Line

990 Ft. from S. Line

_____ Ft. from E. Line

330 Ft. from W. Line

o			

Barber County

Location _____

Rig up _____

Drilling and Remarks:

Derrick

RECORD

Cased _____ in., _____ ft.

Sand _____

Gas _____

Oil _____

Total Depth _____

PRODUCTION

1st 24 hrs. Nat. _____

1st 24 hrs. after shot _____

Gas _____ Cu. Ft.

Dry Hole _____

Abandoned _____

Date

FEB 4 1948

19

S. J. LEWIS

Scout

Adams

Map No. _____ Sec. 21 Twp. 33 R. 12W

Well No. 4 C. R. Smith

Continental Oil Company

CORRECTION Contractor

NW SW SW

SECTION PLAT

_____ Ft. from N. Line

990 Ft. from S. Line

_____ Ft. from E. Line

330 Ft. from W. Line

Barber County

Location _____

Rig up _____

Drilling and Remarks:

Reported
NW NW SW

RECORD

Cased _____ in., _____ ft.

Sand _____

Gas _____

Oil _____

Total Depth _____

PRODUCTION

1st 24 hrs. Nat. _____

1st 24 hrs. after shot _____

Gas _____ Cu. Ft.

Dry Hole _____

Abandoned _____

Date

MAY 20 1953 19

J. G. McGEHEE

Scout