

KANSAS

Barber

Section 21 Township 33 Range 12W

Well No. 5 Smith

Company Continental

Boggs
NORTH

6

		0					

WEST

EAST

SOUTH

Barber

KANSAS

Sec. 21 Twp. 33 R. 12W ✓

Well No. #5 Smith Farm

Continental Company


Boggs Pool

_____ Ft. from N. Line

990' _____ Ft. from S. Line

990' _____ Ft. from E. Line

_____ Ft. from W. Line

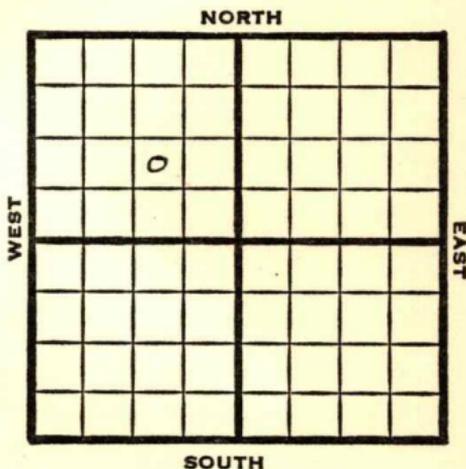

NW SE NW

1949

Elev 1531'

REPORT

- 6/22 Derrick
- 6/28 13" @ 370'
- 7/6 Drlg. 980'
- 7/6 Drlg. 2534'
- 7/12 Drlg. 3366'
- 7/20 **Lans 3870**
- Miss 4472'**
- Viola 4755**
- Simp 4854'**
- TD 4882'
- 7/27 TD 4907'
- 5" @ 4907'
- 8/3 "
- 8/10 "
- 8/17 "
- 8/24 "
- 8/31 TD 4907'
- Simp 4854'**
- Aband.

ABANDONED

Map No. _____ Sec. 21 Twp. 33 R. 12W

Well No. 5 Smith

Continental Company

Contractor _____

NW SE NW

FIRST SECTION REPORT

_____ Ft. from N. Line

990 Ft. from S. Line

990 Ft. from E. Line

_____ Ft. from W. Line

	0		

Barber County

Location _____

Rig up _____

Drilling and Remarks:

Derrick

RECORD

Cased _____ in., _____ ft.

Sand _____

Gas _____

Oil _____

Total Depth _____

PRODUCTION

1st 24 hrs. Nat. _____

1st 24 hrs. after shot _____

Gas _____ Cu. Ft.

Dry Hole _____

Abandoned _____

Date

June 22 19 49

S. J. LEWIS Scout

