


Section 6 Township 33 Range 12W

Well No. #2 Alexander

Company Orville Parker

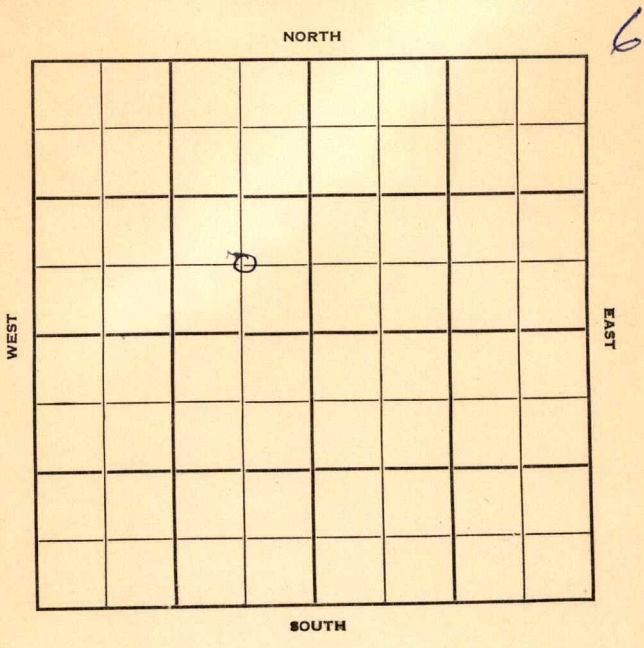

Sec. 6 Twp. 33 R. 12 W

Well No. # 2 Alexander Farm

Orville Parker Company

Contractor

Ft. from N. Line

660


Ft. from S. Line

660

Ft. from E. Line

Ft. from W. Line

C SE NW

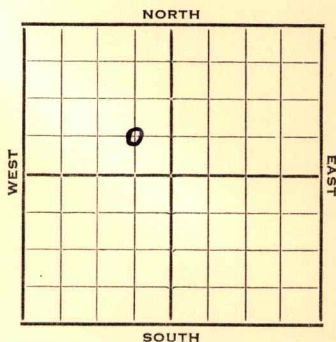

1952 Elev. 1693 REPORT

4/16 MI

4/23 "

4/30 10" @ 225' WOC

5/7 Drlg. 3020'

5/14 Tongonoxie sd 3873'

DST 3874-85, 10 mins. gas in 2"
gauge 3,880,000 cu ft gas 1200#
FP 1200 5" @

5/21 RTD 3885' DP CO 3885'
54 cu ft gas thru csg.

5/28 NR

6/11 "

6/18 "

6/25 "

7/2 "

7/9 "

7/17 "

7/23 "

7/30 "

OVER

1952

8/6 Spud 4-27-52

Gas Well

TD 3890

10" @ 225 Tonganoxie sand 3873

DST 3874-85 opn 10 min.

gas in 2 mi . gauge 3,880,000

gas 1200# 5" @ 3874

TD 3890 CO to 3890

Comp. 129,850,000 gas Ind. Prod. test


COMPLETED

County **Barber** State **Kansas**
 Sec. **6** (Blk.) **33** (Sur.) **12W** Map No.

Operator **Orville Parker**

Well No. **2** Farm **Alexander**

Elev. Location **C SE NW**

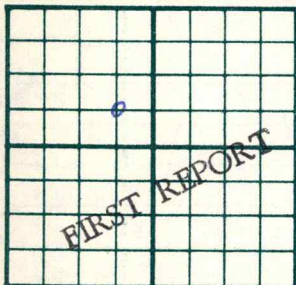

660 Ft. From **S** Line **NW**

660 Ft. From **E** Line Quarter

1st. Report **APR 16 1952**

Completion

Remarks


Spudding Date

Drlg. Data

MI

J. G. McGEHEE

County Barber State Kansas
 Sec. 6 (Blk. Twp.) 33 (Sur. Rge.) 12W Map No.
 Operator Orville Parker
 Well No. 2 Farm Alexander
 Elev. 1693 Location C SE NW

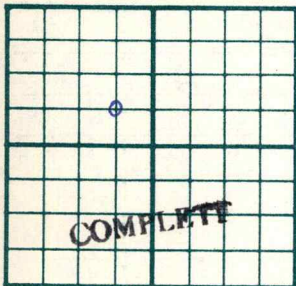

660 Ft. From S Line NW
 660 Ft. From E Line Quarter

1st. Report

Completion AUG 6 1952

Remarks

Spudding Date 4-27-52

Drlg. Data Gas well TD 3890

10" @225 Tonganoxie sand 3873

DST 3874-85 open 10 min. gas in 2 min.

gauge 3,880,000 gas 1200# 5" @ 3874

TD 3890 CO to 3890

Comp. 129,850,000 gas Ind. Prod. test

J. G. McGEHEE