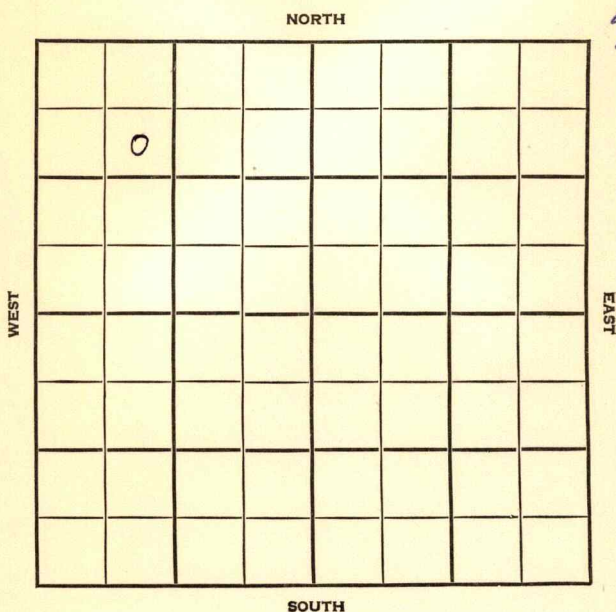


Section 4 Township 33 Range 12 WWell No. #1 Boggs "J"Company Skelly Oil

Barber

KANSAS

SEC.	TWP.	R.
4	33	12 W

WELL NO.

1 Boggs "J"

FARM

COMPANY

Skelly Oil

CONTRACTOR

Wentworth


Boggs

_____ Ft. from N. Line

_____ Ft. from S. Line

_____ Ft. from E. Line

_____ Ft. from W. Line

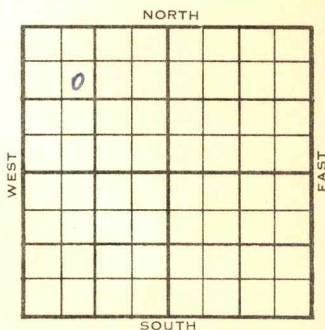

SE NW NW

ELEVATION

REPORT

1955

~~161~~ 1632

8/24

Location

10/5

Comm 8-23-55

8 5/8" @ 346 w/125

H

3724

Irel Sd

3736

L

3928

BKC

4402

Im

4480

TD

4558

DST 4468-4513

open 1 hr gas in 4 min 410 mcfg
in 50 min 1632#

5 1/2" @ 4556/150 CO to 4521

198/4474-4507 200 mcfg

3000 A 90 mcfg frac 7 mcfg

Comp 6,210 mcfgpd

COMPLETED

County Barber Elev. 1632
Sec. 4 Twp. 33 Rge. 12W
Company Skelly Oil
Farm Name Boggs "J" No. 1

TOPS	DEPTH	LOG	DATUM
Anh.			
Tr.			
H.		3724	2092
Dg.		3736	2104
Bl.			
L.	3928		2296
K.C.			
B.K.C.		4402	2770
Ce.			
C.			
M. <i>lm</i>	4480		2848
M.			
K.			
Mz.			
Mo.			
V.			
S.			
S.			
A.			
R.			
Pe.			
G.			
T.D.	4558		

Loc. in Sec. SE NW NW
Geol. Wentworth
Contr. Boggs
Pool COMPLETE

Date Comm. 8-23-55 OCT 5 1955
8 5/8" @ 346/125 DST 4468-4513
open 1 hr. gas in 4 min. 110 mcf
in 50 min. 1632# 5 1/2" @ 4556/150
CO to 4521 198/ 4474-4507 200 mcf
3000 A 90 mcf frac 7 mcf
Comp. 6,210 mcf/gpd

County Barber

Elev. _____

Sec. 4Twp. 33Rge. 12WCompany Skelly OilFarm Name Boggs "J"No. 1

TOPS

DEPTH

LOG

DATUM

Loc. in Sec. _____

Anh. _____

T.P. _____

H. _____

Tr. _____

Dg. _____

B.L. _____

L. _____

K.C. _____

B.K.C. _____

Ce. _____

C. _____

M. _____

M. _____

K. _____

Mz. _____

Mq. _____

V. _____

S. _____

S. _____

A. _____

R. _____

P.E. _____

G. _____

T.D. _____

SE NW NW

Geol. _____

Contr. _____

Wentworth

Pool

BoggsFIRST REPORT
AUG 24 '95

Date Comm. _____

Location _____

Co.

Lse.

No.

Sec.

T.

R.