


Section 5 Township 33 Range 12W

Well No. 1 Boggs "D"

Company Skelly

Boggs  
NORTH

14

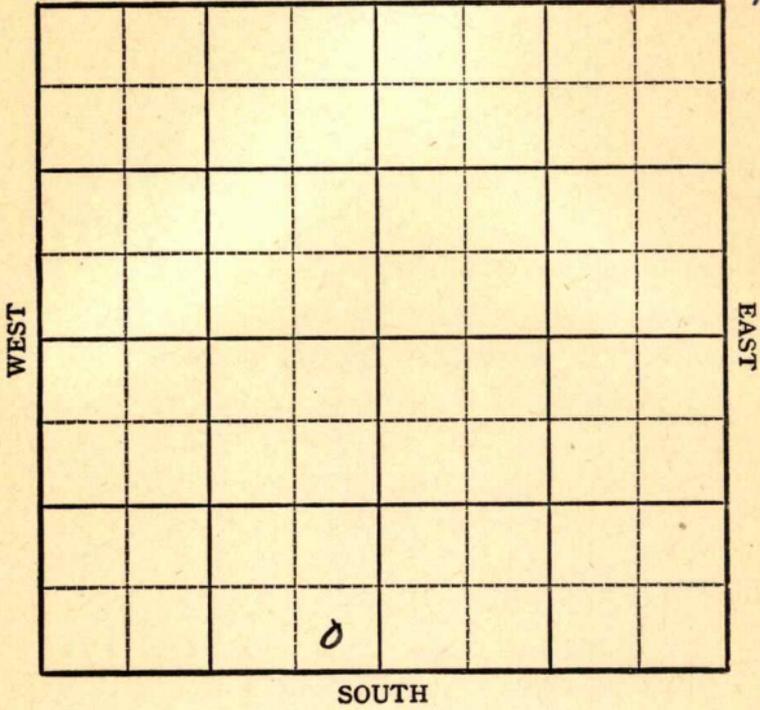

Sec. 5 Twp. 33 R. 12-W

Well No. #1 Boggs "D" Farm

Skelly Company


Boggs Pool

         Ft. from N. Line

330 Ft. from S. Line

330 Ft. from E. Line

         Ft. from W. Line

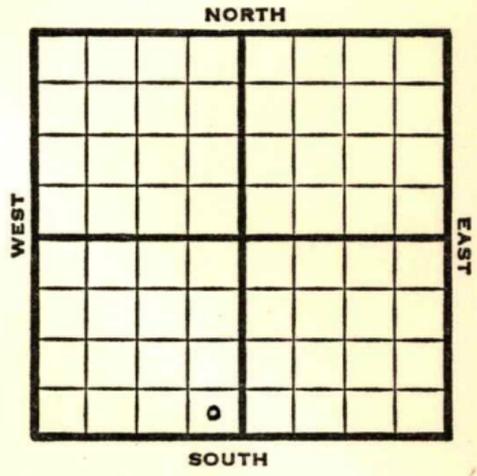

SE SW

1949

**Elev 1581'** REPORT

1/26

8" @ 482'

2/2

Drlg 2390'

2/9

Drlg 3600'

2/16

**T. Conglomerate Sd 3777-85**

TD 3792'

5" @ 3778'

2/23

TD 3792'

**Tonganopie 3777' - 7'**

5" @ 3778'

205,970,000 Gas

1235# R Pr.

Comp

**COMPLETED**

Kansas

Map No. \_\_\_\_\_ Sec. 5 Twp. 33 R. 12W

Well No. 1 Boggs "D"

Skelly Company

FIRST REPORT Contractor

SE SW


SECTION PLAT

\_\_\_\_\_ Ft. from N. Line

330 Ft. from S. Line

330 Ft. from E. Line

\_\_\_\_\_ Ft. from W. Line

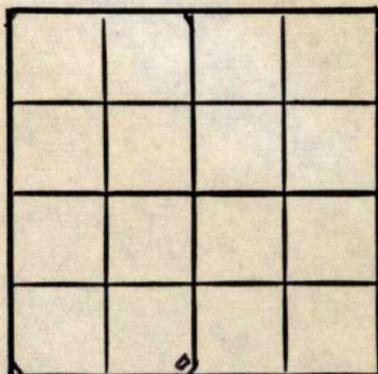

Barber County

Location \_\_\_\_\_

Rig up \_\_\_\_\_

Drilling and Remarks:

8" @ 482

RECORD

Cased \_\_\_\_\_ in., \_\_\_\_\_ ft.

Sand \_\_\_\_\_

Gas \_\_\_\_\_

Oil \_\_\_\_\_

Total Depth \_\_\_\_\_

PRODUCTION

1st 24 hrs. Nat. \_\_\_\_\_

1st 24 hrs. after shot \_\_\_\_\_

Gas \_\_\_\_\_ Cu. Ft.

Dry Hole \_\_\_\_\_

Abandoned \_\_\_\_\_

Date

JAN 26 1949 19

S. J. LEWIS Scout

Map No. K61 Sec. 5 Twp. 33 R. 12W

Well No. 1 Boggs "D"

Skelly Company

COMPLETE

Contractor

SE SW

*E. 1, 1581*

SECTION PLAT


\_\_\_\_\_ Ft. from N. Line

330 Ft. from S. Line

330 Ft. from E. Line

\_\_\_\_\_ Ft. from W. Line

Barber County

Location \_\_\_\_\_

Rig up \_\_\_\_\_

Drilling and Remarks:

*Tring an Opie 8777  
5" @ 8775.*

*205,970,000 gal*

*1285-R/E*

RECORD

Cased \_\_\_\_\_ in., \_\_\_\_\_ ft.

Sand \_\_\_\_\_

Gas \_\_\_\_\_

Oil \_\_\_\_\_

Total Depth 8774

PRODUCTION

1st 24 hrs. Nat. \_\_\_\_\_

1st 24 hrs. after shot \_\_\_\_\_

Gas \_\_\_\_\_ Cu. Ft.

Dry Hole \_\_\_\_\_

Abandoned \_\_\_\_\_

Date

FEB 23 1949

19

S. J. LEWIS

Scout