


Section 5 Township 33 Range 12 W

Well No. # 2 Boggs "D"

Company Skelly

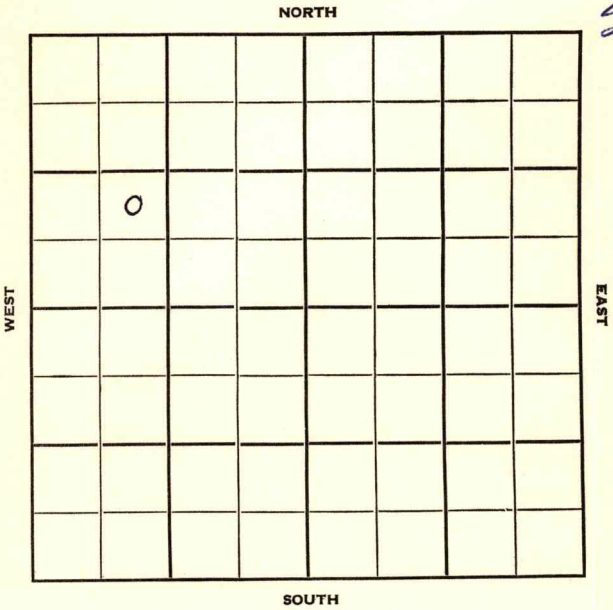

Barber

KANSAS

Sec. 5 Twp. 33 R. 12 W ✓

Well No. # 2 Boggs "D" Farm _____

Skelly Company _____

Contractor _____

Boggs Pool


_____ Ft. from N. Line

990 Ft. from S. Line

_____ Ft. from E. Line

990 Ft. from W. Line

NE SW NW

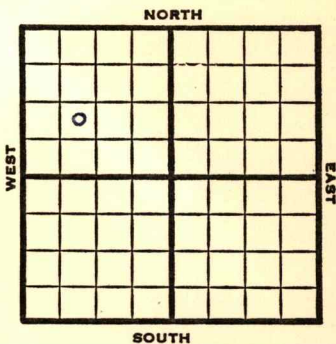

1951

Elev. 1664' REPORT

3/28

Location

5/2

Spud 3-27-51

D&A TD 5067

8" @ 423

DST 3866-80 opn 1 hr.

Rec. 210,000 gas 1500' sw

4' free oil

Miss 4523 Viola 4805

Simp. sh 4906 Simp sd 4912

DST 4900-70 opn 40 min.

Rec. 12' mud **Arb. 5004** TD 5067

ABANDONED

