


Barber

FORM 51 IOM 12-46 PETROL

Section 6 Township 33 Range 12W **KANSAS**

Well No. 1 Alexander

Company Skelly

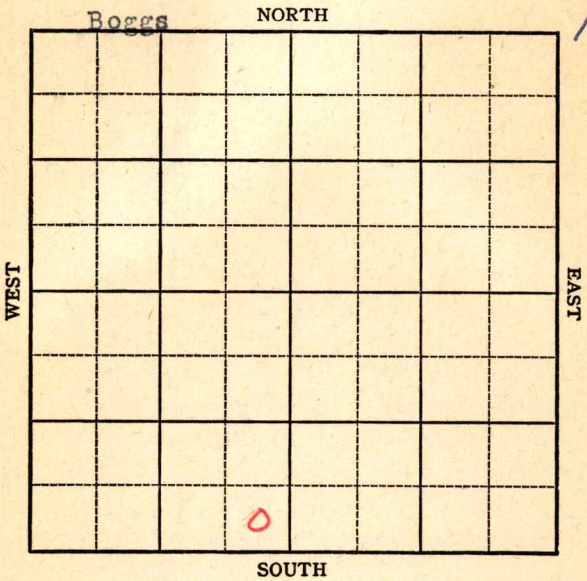

KANSAS


Barber

Sec. 6 Twp. 33 R. 12-WWell No. #1 Alexander FarmSkelly Company

Boggs

 Ft. from N. Line330 Ft. from S. Line330 Ft. from E. Line Ft. from W. Line

SE SW

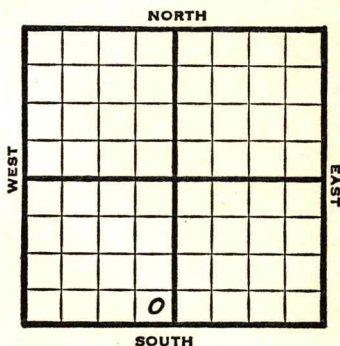

1947

Elev. 1633' REPORT

6/11 Location

6/17 "

6/24 "

7/1 8" @ 580'
WOC

7/8 Drlg. 2750'

7/16 Lansing 3939'
Drlg 4010'7/22 Mississippi 4488
Drlg. 47007/30 Viola 4796'
Simp. Sd. 4932'
Arb. 4994'
TD 5050'

ABANDONED

Map No. _____ Sec. 6 Twp. 33 R. 12W


Well No. 1 Alexander

Skelly Company

FIRST REPORT Contractor

SE SW

SECTION PLAT

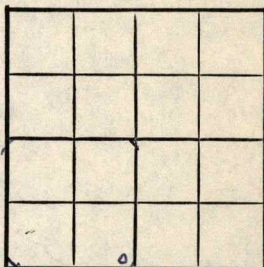

_____ Ft. from N. Line

330 Ft. from S. Line

330 Ft. from E. Line

_____ Ft. from W. Line

Barber County

Location X

Rig up _____

Drilling and Remarks:

RECORD

Cased _____ in., _____ ft.

Sand _____

Gas _____

Oil _____

Total Depth _____

PRODUCTION

1st 24 hrs. Nat. _____

1st 24 hrs. after shot _____

Gas _____ Cu. Ft.

Dry Hole _____

Abandoned _____

Date

JUN 11 1947

19

S. J. LEWIS

Scout

Map No. 61 Sec. 6 Twp. 33 R. 12W

Well No. 1 Alexander

Skelly Company

ABANDONED

Contractor

SE SW

E 11628
SECTION PLAT

_____ Ft. from N. Line

330 Ft. from S. Line

330 Ft. from E. Line

_____ Ft. from W. Line

Barber County

Location _____

Rig up _____

Drilling and Remarks:

Viola 4796
Brng. Bd 4932
Per 4994

RECORD

Cased _____ in., _____ ft.

Sand _____

Gas _____

Oil _____

Total Depth 5000

PRODUCTION

1st 24 hrs. Nat. _____

1st 24 hrs. after shot _____

Gas _____ Cu. Ft.

Dry Hole _____

Abandoned _____

Date

JUL 30 1947

19

S. J. LEWIS

Scout