


Section 6 Township 33 Range 12W

Well No. #1 Alexandria

Company Orval Parker

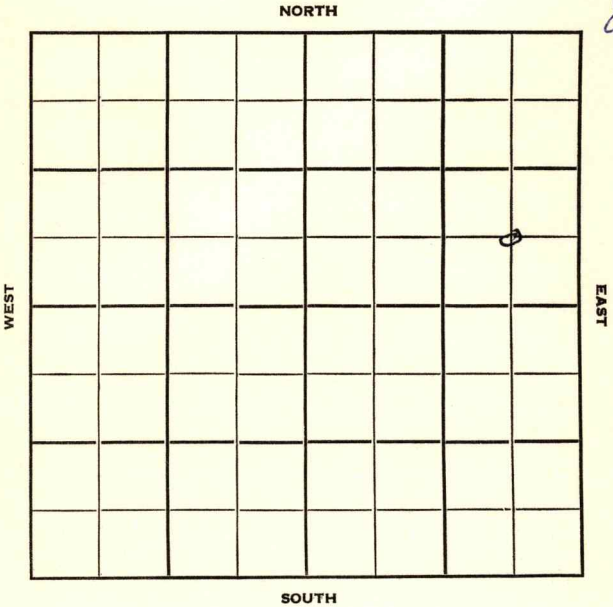

Barber

KANSAS

Sec. 6 Twp. 33 R. 12W ✓

Well No. #1 Alexandria Farm

Orval Parker Company

Gabbert & Jones - Contr Contractor

Wildcat


 Ft. from N. Line

660' Ft. from S. Line

660' Ft. from E. Line

 Ft. from W. Line

C SE NE

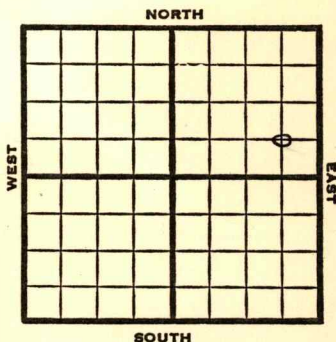

1951 **Elev. 1684'** REPORT

2/14 MIM

4/4 Spud 2-21-51

Gas Well TD 3905

10-3/4" @ 204

Doug 3885

DST 3886-95 opn 5 min

Rec. 5,480,000 gas TD 3905

7" @ 3886 Comp. 12,472,000 gas

1105#

COMPLETED

County **Barber** State **Kansas**Sec. **6** (Blk.) **33** (Sur.) **12W** Map No.Operator **Orval Parker**Well No. **1** Farm **Alexandria**Elev. Location **C SE NE**

FIRST REPORT									

660 Ft. From **S** Line **NE**660 Ft. From **E** Line Quarter1st. Report **FEB 14 1951**

Completion

Remarks **Superior farmout****Gabbert & Jones - Contr.**

Spudding Date

Drlg. Data **Wildcat****M I M****J. E. TYRA**

County	Barber		State	Kansas	
Sec.	6	(Blk.) (Twp.)	33	(Sur.) (Rge.)	12W Map No.
Operator	Orval Parker				
Well No.	1	Farm	Alexandria		
Elev.	1684	Location	C SE NE		
			660 Ft. From S Line NE		
			660 Ft. From E Line Quarter		
			1st. Report		
			Completion APR 4 1951		
			Remarks Wildcat		
			Gabbert & Jones - Contr.		
			Spudding Date 2-21-51		
			Drlg. Data Gas well TD 3905		
			10 3/4" @ 204 Doug. 3885 DST 3886-95		
			open 5 min. Rec. 5,480,000 gas TD 3905		
7" @ 3886 Comp. 12,472,000 gas 1105#					

J. E. TYRA