
FORM 51 25M 8-50 WESTERN Barber KANSAS

Section 7 Township 33 Range 12W

Well No. #1 Alexander

Company Skelly

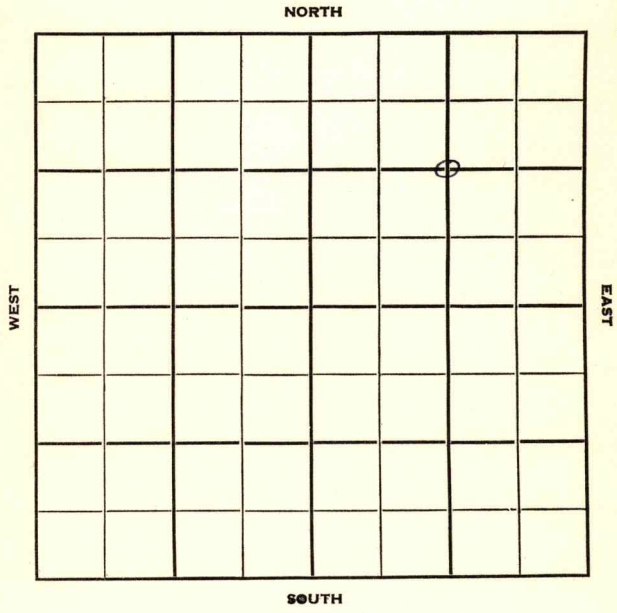

FORM 252-B
10M 8-51 TPCO.

Barber

KANSAS

Sec. 7 Twp. 33 R. 12W

Well No. #1 Alexander Farm

Skelly Company

Hulme - Contr. Contractor


1320' Ft. from N. Line

Ft. from S. Line

1320' Ft. from E. Line

Ft. from W. Line

C NE/4

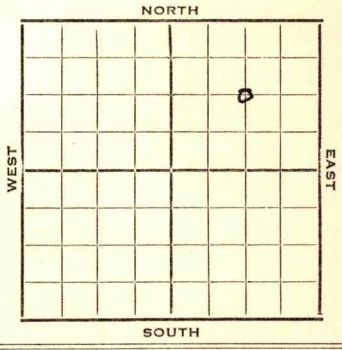

1952	Elev. 1595' REPORT
4/9	Spud 4-6-52 8" @ 538 WOC
4/23	Tonganoxie sd 3790 DST 3292-3805 1 hr. 185' SW 1180# DST 3805-60 1 hr. 10' M Drlg. ahead
4/30	Spud 4-6-52 D&A TD 3860' 8" @ 538' Elgin sd 3603 Tonganoxie sd 3790 DST 3792-3805 open 1 hr. rec. 185' sw DST 3805-60 open 1 hr. rec. 10' mud TD 3860 D&A

ABANDONED

FORM 275 FOR SALE BY KANSAS BLUE PRINT CO.


County Barber State Kansas

Sec. 7 (Blk. Twp.) 33 (Sur. Rge.) 12W Map No.

Operator Skelly

Well No. 1 Farm Alexander

Elev. Location C NE/4

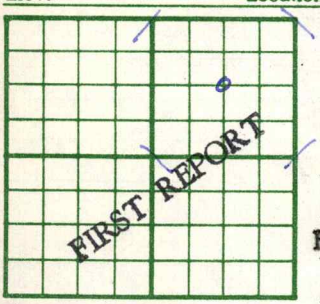

1320 Ft. From N Line NE

1320 Ft. From E Line Quarter

1st. Report APR 9 1952

Completion

Remarks

Hulme - Contr.

Spudding Date 4-6-52

Drlg. Data

8" @ 538 W.O.C.

J. G. McGEHEE

FORM 275 FOR SALE BY KANSAS BLUE PRINT CO.


County Barber State Kansas

Sec. 7 (Blk. Twp.) 33 (Sur. Rge.) 12W Map No.

Operator Skelly Oil

Well No. 1 Farm Alexander

Elev. 1595 Location C NE/4

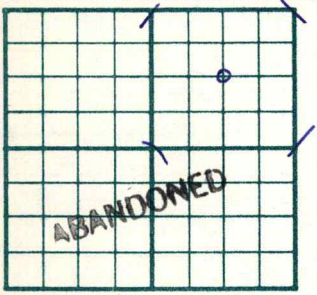

1320 Ft. From N Line NE

1320 Ft. From E Line Quarter

1st. Report

Completion APR 30 1952

Remarks

Hulme Drlg. - Contr.

Spudding Date 4-6-52

Drlg. Data D & A TD 3860

8" @ 538 Elgin sand 3603 Tonganoxie sand 3790 DST 3792-3805 open 1 hr. Rec. 185' sw DST 3805-60 open 1 hr. Rec. 10' mud TD 3860

D & A

J. G. McGEHEE