


Section 7 Township 33S Range 12W

Well No. #1 Alexander "A"

Company Skelly Oil Co.

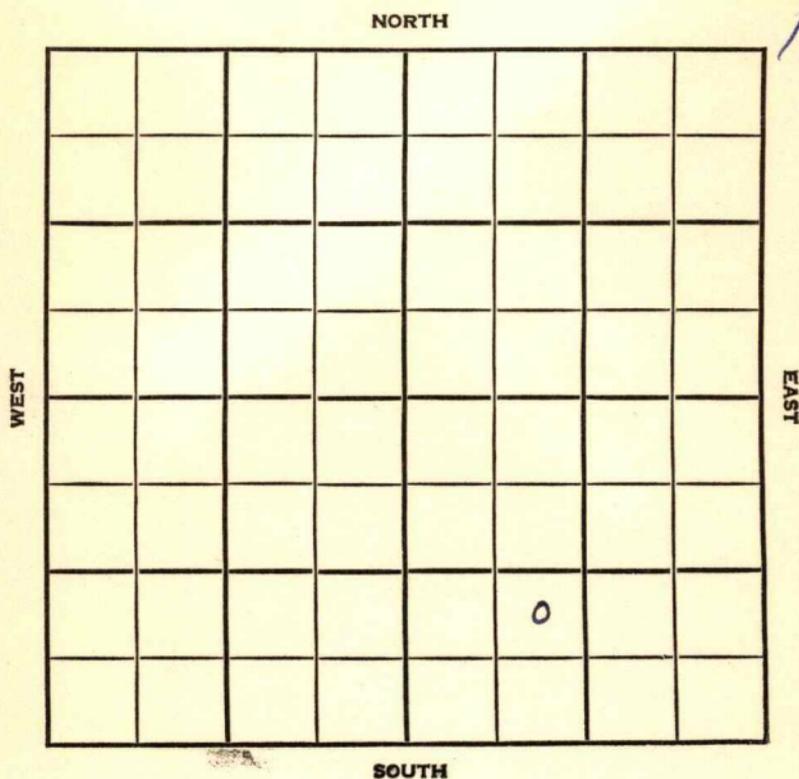

Barber KANSAS

SEC. 7 TWP. 33S R. 12W

WELL NO. 1 Alexander "A" FARM

COMPANY Skelly Oil Co.

CONTRACTOR Hulme Tools


Medicine Lodge

_____ Ft. from N. Line

990 _____ Ft. from S. Line

_____ Ft. from E. Line

990 _____ Ft. from W. Line

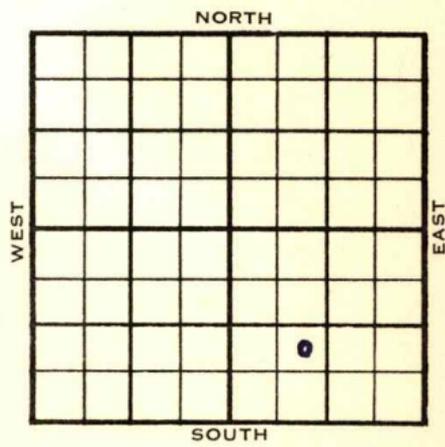

NE SW SE

1954 ELEVATION 1573' REPORT

12/8
1955
2/23

Location

Spud 12-9-54 Gas well TD 4504'
8" @ 481 Elgin 3609' Heeb 3724'
Ireland 3735
DST 3720-80 open 1 1/2 hr 750,000 CFG
rec 140' mud 1495# Tonganoxie sd.
3806
DST 3800-25, open 1 hr rec 10' mud 520#
Lans. 3896 B KC 4371' Marm. 4380
Miss. 4433
DST 4428-78 open 1/2 hr gas in 2 min
1,020,000 CFG, 200' HGCM 1645#
TD 4504 5" @ 4504 DP 4490
216/4440-76 750,000 CFG 500 A
1,020,000 CFG sd-oil-frac 9,580,000
CFG 1525# F/3,460,000 CFG
Comp. 514,000 CFGPD

COMPLETED

