


KANSAS

Barber

Section 8 Township 33 Range 12W

Well No. 1 Boggs

Company Skelly

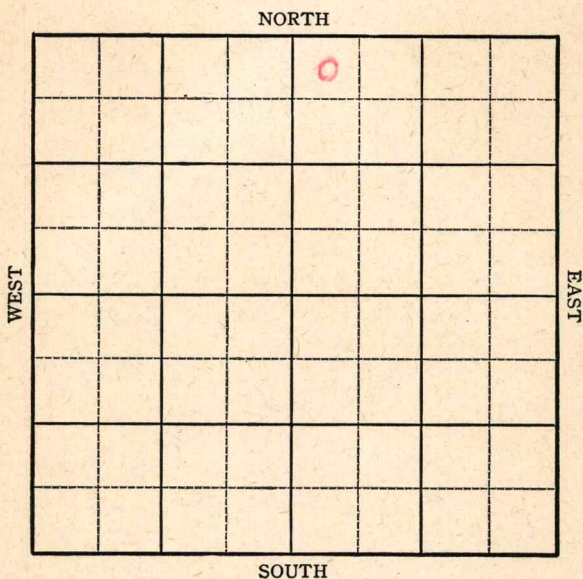

KANSAS

Barber

Sec. 8 Twp. 33 R. 12-W

Well No. #1 Boggs Farm


Skelly Company

330 Ft. from N. Line

 Ft. from S. Line

 Ft. from E. Line

330 Ft. from W. Line

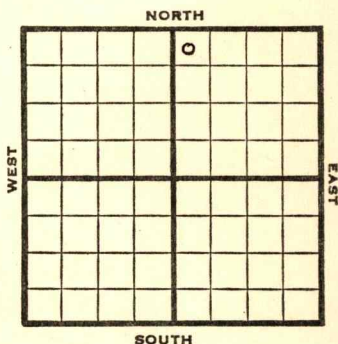

NW NE

1945

Elev. 1600

REPORT

10/17 Derrick

10/24 RUR

10/31 Drlg. 200

11/7 8" @ 408

Drlg. 1885

11/14 Drlg. 3550'

11/21 **Lans 3960**

Miss 4471

Drlg. 4483

11/28 TD 4593

5" @ 4472 RUST

12/5 " " "

12/12 **Miss. 4471**

5" @ 4472

6500 acld

TD 4593

5,094,000 Gas.

1475# R Pr.

COMPLETED

KANSASKansas Pool Name WildcatMap No. 161 Sec. 8 Twp. 33 R. 12WWell No. 1 BoggsSkelly

Company

COMPLETED

Contractor

NW NE

E1/600
SECTION PLAT330 Ft. from N. Line

Ft. from S. Line

Ft. from E. Line

330 Ft. from W. Line

		<u>6</u>	

Barber County

Location

Rig up

Drilling and Remarks:

Misc 44715" 44726500 oil5,094,000 Gas1475 # R P**RECORD**

Cased _____ in., _____ ft.

Sand _____

Gas _____

Oil _____

Total Depth 4523**PRODUCTION**

1st 24 hrs. Nat. _____

1st 24 hrs. after shot _____

Gas _____ Cu. Ft.

Dry Hole _____

Abandoned _____

Date


DEC 12 1945 19S. J. LEWIS

Scout

KANSAS
Kansas Pool Name WildcatMap No. 61 Sec. 8 Twp. 33 R. 12WWell No. 1 BoggsSkelly CompanyFIRST REPORT Contractor

NW NE

SECTION PLAT

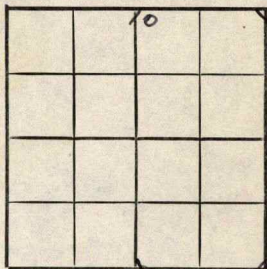330 Ft. from N. Line Ft. from S. Line Ft. from E. Line330 Ft. from W. LineBarber CountyLocation Rig up Drilling and Remarks:
derrick

RECORD

Cased in., ft.Sand Gas Oil Total Depth

PRODUCTION

1st 24 hrs. Nat. 1st 24 hrs. after shot Gas Cu. Ft.Dry Hole Abandoned

Date

OCT 17 1945

19

S. J. LEWIS

Scout